

**OREGON CORNER RESTORATION FORM**

Section 6 Township 3N Range 29E  
County Umatilla Date: 09/15/09

Corner Designation: 3N29C1

1/4 corner common to sections 6, T3NR29E, 1, T3NR28E.

Condition Report Only  
 Not Found  
 Remonumented  
 Unrecorded  
 Surveyed In  
 Referenced Out

Previous Renewals / Surveys, etc.

Originally Surveyed by Gates in 1859. He set a post in a mound of earth.


Monuments and Accessories Found: (Condition and Source)

None.

Diagram



Sketch

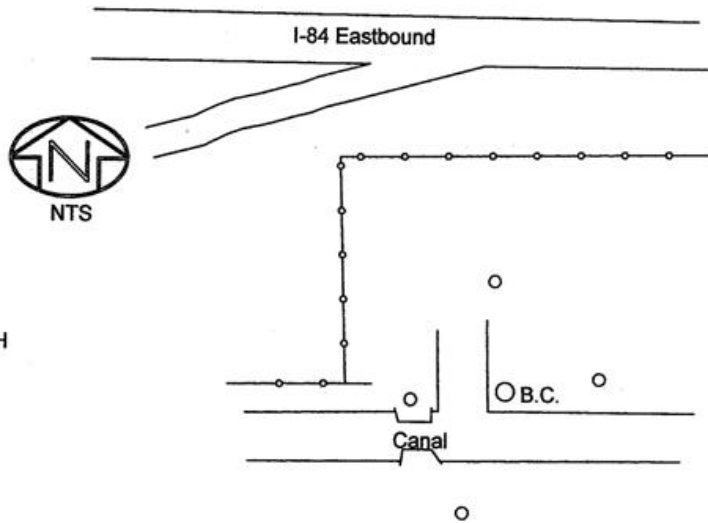

NAD 83/91  
OREGON STATE PLANE NORTH  
INTERNATIONAL FEET

N769148.42  
E8521447.60

LAT - 45° 46' 10.42609" N  
LON - 119° 14' 54.64378" W

Monument (s) Set (Procedures and Description)

Set a 2 1/2" Brass cap on a 1 1/4" x 30" galvanized iron pipe 4 inches above the surface using the West line of the township and best evidence of East-West fencelines as well as the canal.

References Set:

- A 5/8" Iron rebar w/rpc #43406 lies N 5°15' W, 23.16'.
- A 1" Iron rebar w/rpc #43406 lies N 85°45' E, 16.57'.
- A 1" Iron rebar w/rpc #43406 lies S 11° W, 23.65'.
- A 1" Iron rebar w/rpc #43406 lies S 80°45' W, 16.19'.

Location and Comments

From the Rest stop just West of the Echo-Stanfield exit, go to the very East end of the grass and the monument is over the fence and across the canal.

Compass Declination  
17° E

Surveyors Seal

RECEIVED BY:

Firm / Agency

Date: 1-11  
Rec'd By: KE  
No. 11-09-R

Survey One, LLC.  
P.O. Box 382  
Pendleton, OR 97801  
(541) 276-2055

REGISTERED  
PROFESSIONAL  
LAND SURVEYOR

*Robert D. English*  
OREGON  
JANUARY II, 2005  
ROBERT DOUGLAS ENGLISH  
43406LS

RENEWAL DATE: 12/31/09