

OREGON CORNER RESTORATION FORM

Section 10 Township 3N Range 29E
 County Umatilla Date: May 1, 2008

Corner Designation: 3N29E15

Quarter corner to sections 3 and 10, T3N, R29E,
 W.M., Umatilla County, Oregon.

Condition Report Only
 Not found
 Remonumented
 Unrecorded
 Surveyed in
 Referenced out


Previous Renewals / Surveys, etc.

Corner originally set by N. H. Gates under contract No. 84 dated July 22, 1859. His record reads: Set post for 1/4 sec. corner in mound of earth &c. as per instructions. Mr. Peter Zahner in the survey recorded in the Record of Private Surveys Book 1, Page 103 remonumented the original corner. His record reads: I renew by setting a rock, 6x11x17 with pieces of porcelain underneath.


Monument and Accessories found: (condition and source)

An east-west fence and plow berm with a plow line running north.

DIAGRAM

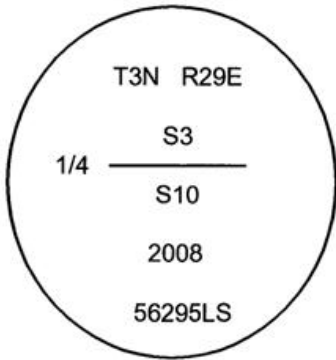

SKETCH

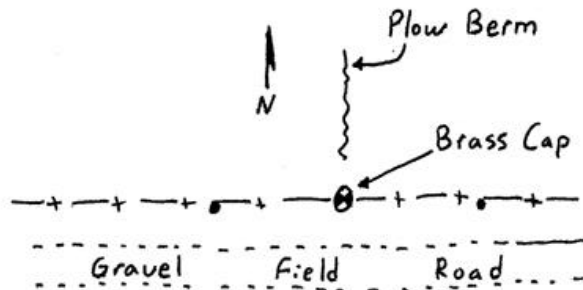

Reference
 Pins

MONUMENT (S) AND ACCESSORIES SET (Procedures and Description)

I proportioned the departure. This point fell at the plow line running north. I held the east-west fence and plow berm for latitude. At the corner point I set a 1 1/2" x 30" galvanized iron pipe with a 2 1/4" brass cap attached stamped as shown in the diagram above.

For references, I set four 5/8" by 24" rebars with 1 1/8" orange plastic caps stamped WTS and 56295LS as described below:

- an iron rebar bears S89°10'06"W, 22.07 feet under the existing fence;
- an iron rebar bears S89°29'46"E, 27.95 feet under the existing fence;
- an iron rebar bears S41°03'54"W, 37.17 feet, 2 feet below the surface;
- an iron rebar bears S47°26'37"E, 40.96 feet, 2 feet below the surface;

The monument was set and references tied using a Trimble R7/R8 RTK GPS system.

Location and comments

Compass Declination

Surveyors Seal

RECEIVED BY:


Umatilla County Surveyor

Date: 5-08


Rec'd By: KK

No. 08-74-B

Firm / Agency
 Witness Tree Surveying
 Address
 P.O. Box G
 Pilot Rock, Or. 97868
 Party Chief
 Stephen K, Haddock

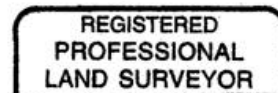

Stephen K. Haddock

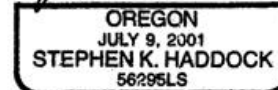

RENEWAL DATE 6-30-09