

**OREGON CORNER RESTORATION FORM**

Section 1,12 Township 3N  
County Umatilla Date: 01/17/11

Range 29E

Corner Designation: 3N29E23

Corner common to section 1 and 12 T3NR29E.

- \_\_\_\_\_ Condition Report Only
- Not Found
- Remonumented
- \_\_\_\_\_ Unrecorded
- Surveyed In
- Referenced Out


**Previous Renewals / Surveys, etc.**

Originally Surveyed by Gates in 1859. He set a post in a mound of earth.


**Monuments and Accessories Found: (Condition and Source)**

None.

**Diagram**

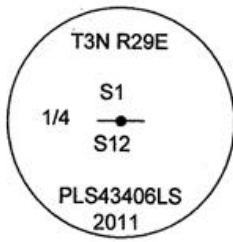

**Sketch**

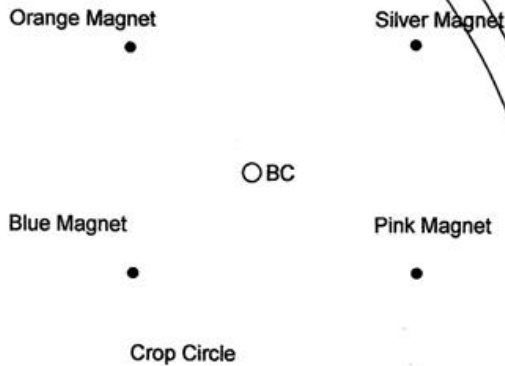

NAD 83/91  
OREGON STATE PLANE NORTH  
INTERNATIONAL FEET

N767135.10  
E8551133.06

LAT - 45° 45' 45.80096" N  
LON - 119° 07' 56.39909" W

**Monument (s) Set (Procedures and Description)**

A 1 1/4" galvanized iron pipe w/ 2 1/2" brass cap, 24" below surface, stamped as shown above. Set by single proportionate method.

**References Set:**

- An Orange Magnet 23" deep, lies N 39°25' W, 21.74'.
- A Silver Magnet 23" deep, lies N 64°48' E, 15.81'.
- A Pink Magnet 23" deep, lies S 29°36' E, 19.26'.
- A Blue Magnet 23" deep, lies S 59°23' W, 17.37'

**Location and Comments**

The corner is North of a Potato Shed.

**Compass Declination**

17° E

**Surveyors Seal**

REGISTERED  
PROFESSIONAL  
LAND SURVEYOR

*Robert D. English*

OREGON  
JANUARY 11, 2005  
ROBERT DOUGLAS ENGLISH  
43406LS

RENEWAL DATE: 12/31/11

**RECEIVED BY:**

Date: 1-11  
Rec'd By: KK  
No. 11-10-R

**Firm / Agency**

Survey One, LLC.  
P.O. Box 382  
Pendleton, OR 97801  
(541) 276-2055