

**OREGON CORNER RESTORATION FORM**

Section 5  
County Umatilla

Township 3N  
Date: 08/31/09

Range 29E

Corner Designation: 3N29E7

1/4 Corner common to sections 1 and 4, T3NR29E.



- Condition Report Only
- Not Found
- Remonumented
- Unrecorded
- Surveyed In
- Referenced Out

**Previous Renewals / Surveys, etc.**

Originally Surveyed by N.H. Gates in 1859. He set a post in a mound of earth.  
 Arnold scribed a 2" Shumak in 1887.  
 PLS 346 set an axle housing over a found stone in survey Q-511-Ax.  
 PLS 933 set a Brass Cap at a found 3/4" pipe in survey 98-11-B.  
 Haddock found a Brass Cap set by PLS 933 and reference the monument in May, 1998.

**Monuments and Accessories Found: (Condition and Source)**

Found A 2.5" B.C.  
 Found a punch mark in bolt lies N 12°30' W, 106.52'.  
 Found a 5/8" Iron rebar w/ypc #852 lies N 87°30' E, 25.65'.  
 Found a 5/8" Iron rebar w/ypc #852 lies N 3°30' E, 49.78'.  
 Found a 5/8" Iron rebar w/ypc #852 lies N 0°45' W, 28.78'.

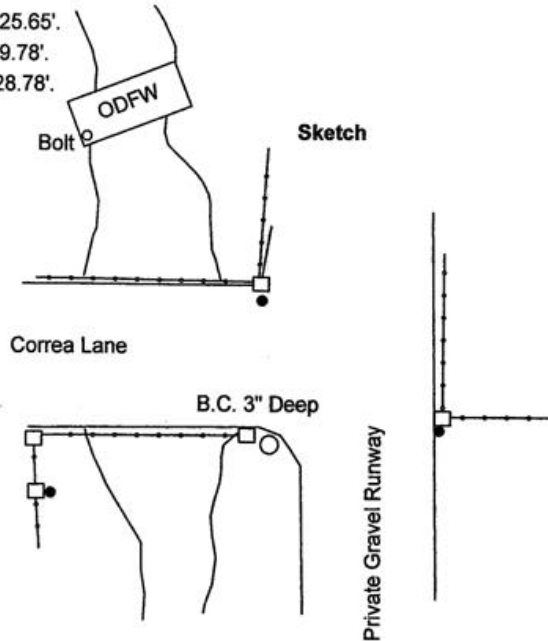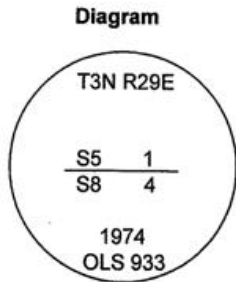

NAD 83/91  
 OREGON STATE PLANE NORTH  
 INTERNATIONAL FEET

N766673.900  
 E8530053.01

LAT - 45° 45' 44.66485" N  
 LON - 119° 12' 53.81421" W

**Monument (s) Set (Procedures and Description)**

None.

**References Set:**

- A 3/4" x 30" Iron rebar w/ypc #43406 lies S 1°30' E, 27.31'.
- A 3/4" x 30" Iron rebar w/ypc #43406 lies S 0°30' E, 11.27'.
- A 3/4" x 30" Iron rebar w/ypc #43406 lies N 0°30' W, 11.08'.
- A 3/4" x 30" Iron rebar w/ypc #43406 lies S 88°00' W, 25.77'.

**Location and Comments**

The corner is .5 miles East of  
 the intersection of Correa lane  
 and Echo Meadows Road.

**Compass Declination**  
 17° E

**Surveyors Seal**

REGISTERED  
 PROFESSIONAL  
 LAND SURVEYOR

*Robert D. English*  
 OREGON  
 JANUARY 11, 2005  
 ROBERT DOUGLAS ENGLISH  
 43406LS

RENEWAL DATE: 12/31/09

**RECEIVED BY:**

Date: 1-11  
 Rec'd By: KK  
 No. 11-10-R

**Firm / Agency**

Survey One, LLC.  
 P.O. Box 382  
 Pendleton, OR 97801  
 (541) 276-2055