

OREGON CORNER RESTORATION FORM

Section 8,9
County Umatilla

Township 3N
Date: 09/15/09

Range 29E

Corner Designation: 3N29G9

Corner common to sections 8 and 9, T3NR29E.

_____	Condition Report Only
<input checked="" type="checkbox"/>	Not Found
<input checked="" type="checkbox"/>	Remonumented
_____	Unrecorded
<input checked="" type="checkbox"/>	Surveyed In
<input checked="" type="checkbox"/>	Referenced Out


Previous Renewals / Surveys, etc.

Originally Surveyed by Gates in 1859. He set a post in a mound of earth.
 Kimbrell set a cedar post over stone coal with stone coal witness marks in private surveys book 1, page 582.
 Krumbein established a point for this corner in 1974, survey #98-11-B.
 Krumbein found a wagon axle at this point in 1981, and set a brass cap.
 D. Haddock set a 2 1/4" brass cap at the road intersection of the North-South section line and the East-West centerline of Bowman Road, which came to the quarter corner according to the county road notes.


Monuments and Accessories Found: (Condition and Source)

Found a 2 1/2" Brass cap set by Haddock.
 Found a 5/8" Iron rebar w/rpc #852 lies S 26°30' W, 68.49'.

Diagram

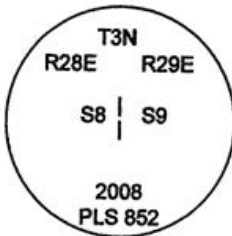

Sketch

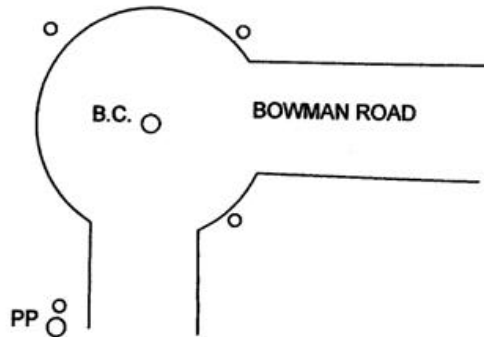

NAD 83/91
 OREGON STATE PLANE NORTH
 INTERNATIONAL FEET

N764086.51
 E8532745.39
 LAT - 45° 45' 18.69861" N
 LON - 119° 12' 16.426466" W

Monument (s) Set (Procedures and Description)

None.

References Set:

A 5/8" Iron rebar w/ypc #43406 lies N 43°45' E, 31.84'.
 A 5/8" Iron rebar w/ypc #43406 lies S 37°15' E, 27.28'.
 A 5/8" Iron rebar w/ypc #43406 lies N 48°45' W, 40.96'.

Location and Comments

The monument is at the very West end of the Bowman Road, in the middle of the culdesac.

Compass Declination
 17° E

Surveyors Seal

REGISTERED
 PROFESSIONAL
 LAND SURVEYOR

Robert D. English
 OREGON
 JANUARY 11, 2005
 ROBERT DOUGLAS ENGLISH
 43406LS

RENEWAL DATE: 12/31/09

RECEIVED BY:

Date: 9-09
 Rec'd By: KR
 No. 09-1462

Firm / Agency

Survey One, LLC.
 P.O. Box 382
 Pendleton, OR 97801
 (541) 276-2055