

**OREGON CORNER RESTORATION FORM**

Section 10,15 Township 3N  
County Umatilla Date: 05/21/10

Range 29E

Corner Designation: 3N29J15

Corner common to section 10 and 15 T3NR29E.

Condition Report Only  
 Not Found  
 Remonumented  
 Unrecorded  
 Surveyed In  
 Referenced Out

**Previous Renewals / Surveys, etc.**



Originally Surveyed by Gates in 1859. He set a post in a mound of earth.

**Monuments and Accessories Found: (Condition and Source)**

None.

**Sketch**

**Diagram**

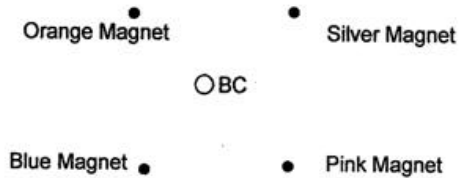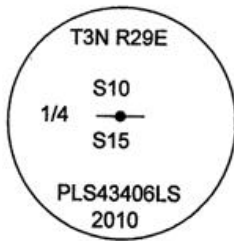

NAD 83/91  
OREGON STATE PLANE NORTH  
INTERNATIONAL FEET

N761610.85  
E8540694.44

LAT - 45° 44' 52.98651" N  
LON - 119° 10' 24.90278" W

**Monument (s) Set (Procedures and Description)**

A 1 1/4" X 30" galvanized iron pipe w/ 2 1/2" brass cap, set 20" below surface, stamped as shown above. Set by single proportionate measure.

**References Set:** "Deep One" magnets by Berntsen.

- A Silver magnet, 18" deep lies N 39°40' E, 23.19'.
- A Pink magnet, 18" deep lies S 60° E, 22.17'.
- A Blue magnet, 18" deep lies S 21°50' W, 20.79'.
- An Orange magnet, 15" deep lies N 48°15' W, 27.52'

**Location and Comments**

The corner is 0.5 miles NE on Hwy 320 out of Echo.

**Compass Declination**  
17° E

**Surveyors Seal**

REGISTERED  
PROFESSIONAL  
LAND SURVEYOR

*Robert Douglas English*  
OREGON  
JANUARY 11, 2005  
ROBERT DOUGLAS ENGLISH  
43406LS

**RECEIVED BY:**

Date: 1-11  
Rec'd By: KE  
No. 11-13-R

**Firm / Agency**

Survey One, LLC.  
P.O. Box 382  
Pendleton, OR 97801  
(541) 276-2055

RENEWAL DATE: 12/31/11