

**OREGON CORNER RESTORATION FORM**

Section 12,13 Township 3N  
County Umatilla Date: 05/06/10

Range 29E

Corner Designation: 3N29J23

Corner common to section 12 and 13 T3NR29E.

_____	Condition Report Only
X_____	Not Found
X_____	Remonumented
_____	Unrecorded
X_____	Surveyed In
X_____	Referenced Out

**Previous Renewals / Surveys, etc.**



Originally Surveyed by Gates in 1859. He set a post in a mound of earth.

**Monuments and Accessories Found: (Condition and Source)**

None.

**Sketch**

**Diagram**

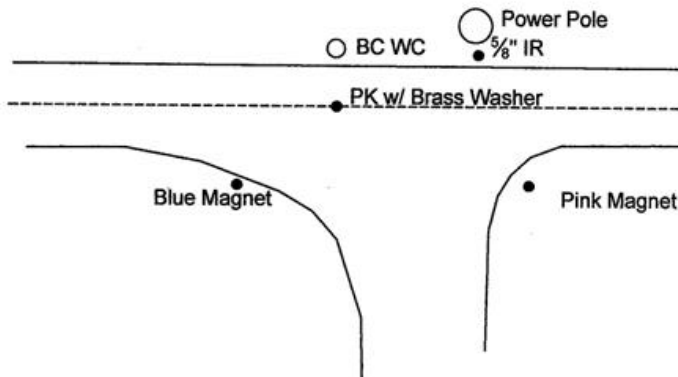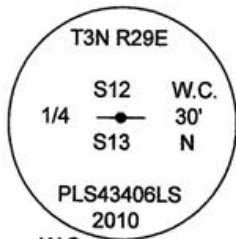

W.C.

NAD 83/91  
OREGON STATE PLANE NORTH  
INTERNATIONAL FEET

N761848.69  
E8551242.98

LAT - 45° 44' 53.59794" N  
LON - 119° 07' 56.11110" W

**Monument (s) Set (Procedures and Description)**

A pk nail w/ 1 1/2" brass washer stamped 43406LS, w/ WC to North. Set by single proportionate Method.

**References Set: "Deep One" magnets by Berntsen.**

A 5/8" x 30" Iron rebar w/rpc #43406 lies N 32°30' E, 32.99'.

A Pink magnet 18" deep lies S 40°20' E, 37.39'.

A Blue magnet 18" deep lies S 36° W, 35.09'.

1 1/2" x 30" Galvanized iron pipe with a 2 1/2" Brass cap monument Witness Corner, stamped as shown above, lies N 0°15' W, 30.00', 6" below the surface.

**Location and Comments**

The corner is 0.5 miles West of the intersection of Coppinger Lane and Hwy. 320. on Hwy. 320.

**Compass Declination**

17° E

**Surveyors Seal**

REGISTERED  
PROFESSIONAL  
LAND SURVEYOR

*Robert D. English*  
OREGON  
JANUARY 11, 2005  
ROBERT DOUGLAS ENGLISH  
43406LS

**RECEIVED BY:**

Date: 1-11  
Rec'd By: KE  
No. 11-18-R

**Firm / Agency**

Survey One, LLC.  
P.O. Box 382  
Pendleton, OR 97801  
(541) 276-2055

RENEWAL DATE: 12/31/11