

CORNER RESTORATION FORM

Township 3N Range 29E & 30E Section 7,12,13&18 County UMATILLA

State OREGON Date 9-15-2014 Number J-1

- Condition Report Only
- Not Found
- Renewed
- Surveyed In
- Referenced

Corner Designation : SECTION 7, 12, 13 & 18

Previous Renewals ORIGINAL SOURCE OF CORNER

UNDER GLO CONTRACT #84 BY N. GATES DATED
JULY 22, 1859 SET POST

Accessories Found:


NONE

BASIS OF BEARINGS, NAD 83/91 OREGON STATE PLANE
 COORDINATES NORTH ZONE:

NORTHING: 761872.854
 EASTING: 8553864.367

MONUMENT DETAIL


Found Set

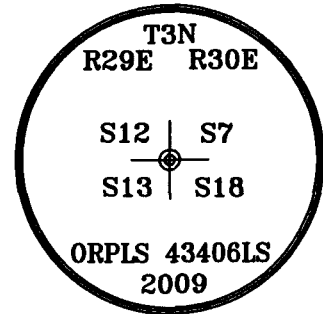

Monument & Accessories Set (Procedure and Description)

FOUND 2 1/2" BRASS CAP BELOW AC GRADE, COVERED WITH A WHITE PIECE OF TIN TO PROTECT THE BRASS CAP. PER SURVEY No. 11-13-R.

Sketch of Monument, Accessories and General Area

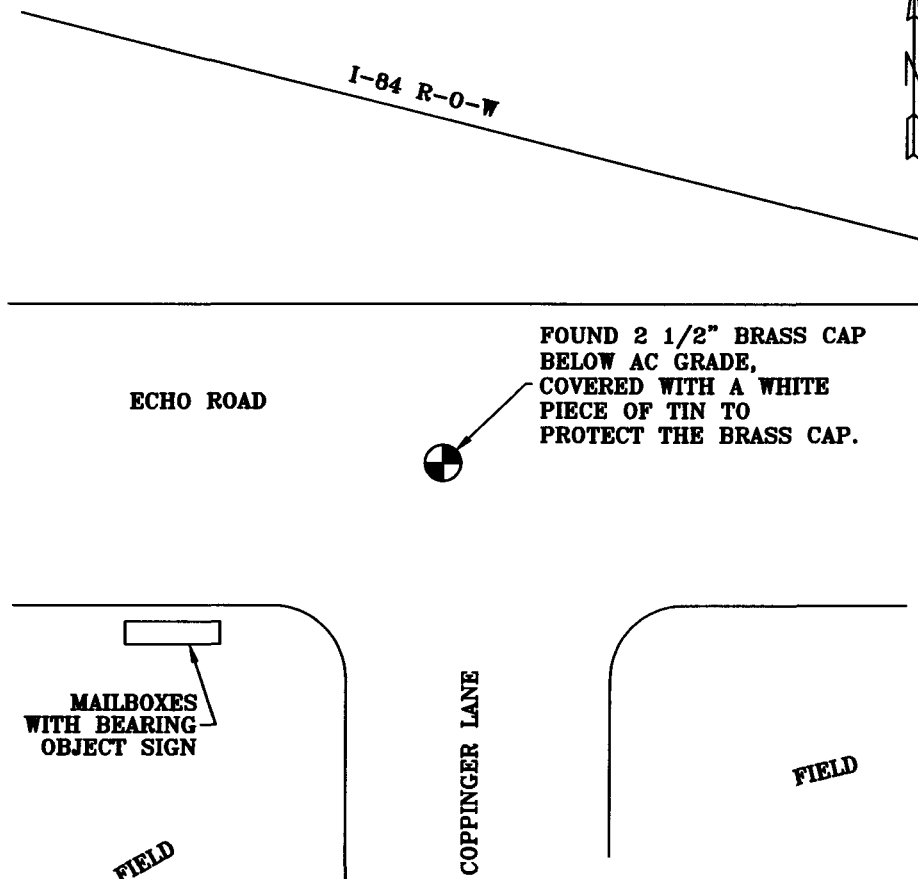

**REGISTERED
PROFESSIONAL
LAND SURVEYOR**

Lance Clark King

**OREGON
MAY 10, 2011
LANCE CLARK KING
61420**

RENEWS: 6/30/2017

Agency:
 CK3, LLC
 945 W. ORCHARD
 HERMISTON OREGON 97838
 OFFICE: 541-587-2345
 FAX: 541-587-2305
 WEB: CK3LLC.NET
 Field Book # 0-298

**COUNTY SURVEYOR
RECORDING INFO**

Received *Jay Roberts*
 Filed 6/12/2015
 Survey No. 15-050-C
 Drawing No. C-853
 Index No. J-1