

OREGON CORNER RESTORATION FORM

Section 16,17
County Umatilla

Township 3N
Date: 03/08/10

Range 29E

Corner Designation: 3N29L9

1/4 Corner common to sections 16,17 T3NR29E

- Condition Report Only
- Not Found
- Remonumented
- Unrecorded
- Surveyed In
- Referenced Out

Previous Renewals / Surveys, etc.


Originally Surveyed by Gates, set a post in a mound of earth, 1859.
PLS 933 set a brass cap at this point in Survey #S-158-C, 1981.
Haddock set a 2 1/4" Brass cap in LCR 98-155-C.

Monuments and Accessories Found: (Condition and Source)


Brass cap set by Haddock.

- A 5/8" Iron rebar w/rpc #852 lies N 34°26' W, 246.50'.
- A 5/8" Iron rebar w/rpc #852 lies N 24°59' E, 364.40'.
- A 5/8" Iron rebar w/rpc #852 lies N 68°38' W, 321.60'.
- A 5/8" Iron rebar w/rpc #852 lies S 31°38' W, 351.70'.

Diagram

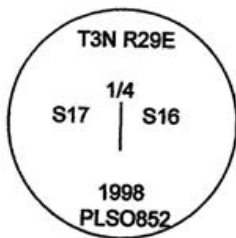

Sketch

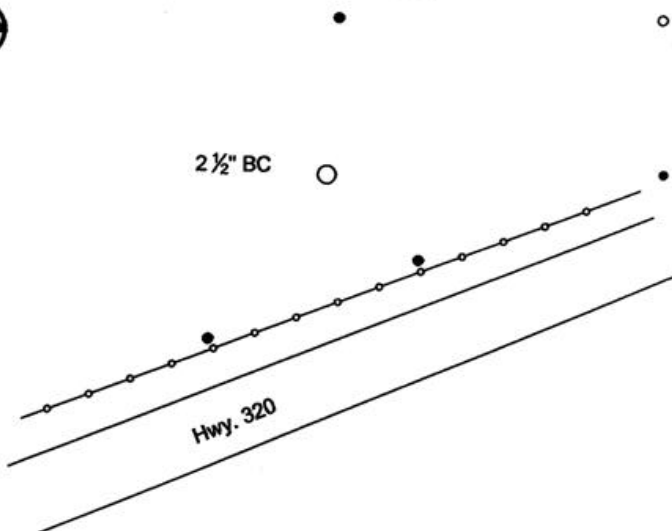

NAD 83/91
OREGON STATE PLANE NORTH
INTERNATIONAL FEET

N758790.95
E8532787.33

LAT - 45° 44' 26.41122408" N
LON - 119° 12' 17.02562328" W

Monument (s) Set (Procedures and Description)

None.

References Set:

Location and Comments

The corner is on the West edge of Echo North of Hwy. 320, in Snow Ranches field.

Compass Declination

17° E

Surveyors Seal

REGISTERED
PROFESSIONAL
LAND SURVEYOR

Robert D. English
OREGON
JANUARY 11, 2005
ROBERT DOUGLAS ENGLISH
43406LS

RENEWAL DATE: 12/31/11

RECEIVED BY:

Date: 3-10
Rec'd By: KK
No. 10-29-R

Firm / Agency

Survey One, LLC.
P.O. Box 382
Pendleton, OR 97801
(541) 276-2055