

**OREGON CORNER RESTORATION FORM**

Section 16,17 Township 3N  
County Umatilla Date: 03/08/10

Range 29E

Corner Designation: 3N29L9

1/4 Corner common to sections 16,17 T3NR29E

- Condition Report Only
- Not Found
- Remonumented
- Unrecorded
- Surveyed In
- Referenced Out


**Previous Renewals / Surveys, etc.**

Originally Surveyed by Gates, set a post in a mound of earth, 1859.  
PLS 933 set a brass cap at this point in Survey #S-158-C, 1981.  
Haddock set a 2 1/4" Brass cap in LCR 98-155-C.


**Monuments and Accessories Found: (Condition and Source)**

Brass cap set by Haddock.  
A 5/8" Iron rebar w/rpc #852 lies N 34°26' W, 246.50'.  
A 5/8" Iron rebar w/rpc #852 lies N 24°59' E, 364.40'.  
A 5/8" Iron rebar w/rpc #852 lies N 68°38' W, 321.60'.  
A 5/8" Iron rebar w/rpc #852 lies S 31°38' W, 351.70'.

**Diagram**

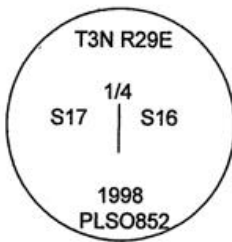

**Sketch**

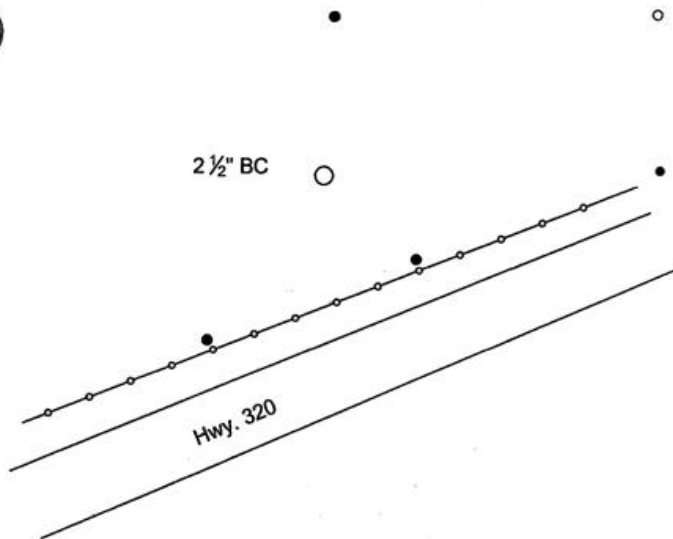

NAD 83/91  
OREGON STATE PLANE NORTH  
INTERNATIONAL FEET

N758786.11  
E8532792.66

LAT - 45° 44' 26.36742" N  
LON - 119° 12' 16.95847" W

**Monument (s) Set (Procedures and Description)**

None.

**References Set:**

None.

**Location and Comments**

The corner is on the West edge of Echo North of Hwy. 320, in Snow Ranches field.

**Compass Declination**

17° E

**Surveyors Seal**

REGISTERED  
PROFESSIONAL  
LAND SURVEYOR

*Robert D. English*  
OREGON  
JANUARY 11, 2005  
ROBERT DOUGLAS ENGLISH  
43406LS

**RECEIVED BY:**

Date: 1-11  
Rec'd By: KK  
No. 11-14-R

**Firm / Agency**

Survey One, LLC.  
P.O. Box 382  
Pendleton, OR 97801  
(541) 276-2055

RENEWAL DATE: 12/31/11