

**OREGON CORNER RESTORATION FORM**

Section 15,16,21,22 Township 3N  
County Umatilla Date: 03/11/10

Range 29E

Corner Designation: 3N29N13

Corner common to Sections 15,16,21 and 22 T3NR29E.

- Condition Report Only
- Not Found
- Remonumented
- Unrecorded
- Surveyed In
- Referenced Out


**Previous Renewals / Surveys, etc.**

Originally Surveyed by N.H. Gates in 1859. He set a post in a mound of earth with charcoal.  
 Perry found a basalt rock in a survey in 1919, book 2 page 308.  
 PLS 933 set a brass cap in place of rock in survey #Q-1655-B, and a Brass cap witness corner  
 S89°13'01"W, 320.00'.  
 PLS 852 referenced the found Brass cap, LCR #98-155-C


**Monuments and Accessories Found: (Condition and Source)**

A 2.5" B.C. as shown below.  
 A 5/8" Iron rebar w/rpc #852 lies N 63° 50' E, 85.10', in top of concrete headgate.

Diagram

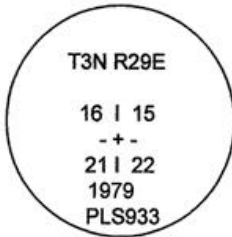

Sketch

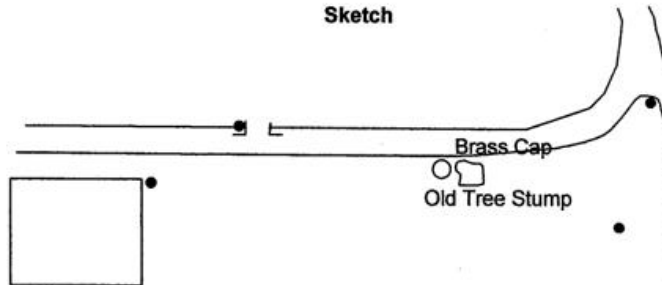

NAD 83/91  
 OREGON STATE PLANE NORTH  
 INTERNATIONAL FEET

N756280.67  
 E8538174.02

LAT - 45° 44' 00.77592" N  
 LON - 119° 11' 01.66560" W

**Monument (s) Set (Procedures and Description)**

None.

**References Set:**

- A 5/8"x30" Iron rebar w/rpc #43406, near the corner of the garage, lies S 86°50' W, 85.64'.
- A 5/8"x30" Iron rebar w/rpc #43406, near a concrete headgate, lies N 74° W, 50.45'.
- A 5/8"x30" Iron rebar w/rpc #43406, lies S 64°30' E, 60.54'.

**Location and Comments**

The corner is located South of Echo  
 0.5 miles on Hwy. 30. Near a farm house,  
 owned by Dick Snow.

**Compass Declination**  
 17° E

**Surveyors Seal**

REGISTERED  
 PROFESSIONAL  
 LAND SURVEYOR

*Robert D. English*  
 OREGON  
 JANUARY 11, 2005  
 ROBERT DOUGLAS ENGLISH  
 43406LS

RENEWAL DATE: 12/31/11

RECEIVED BY:

Date: 1-11  
 Rec'd By: KE  
 No. 11-15-R

**Firm / Agency**

Survey One, LLC.  
 P.O. Box 382  
 Pendleton, OR 97801  
 (541) 276-2055