

**OREGON CORNER RESTORATION FORM**

Section 14,15,22,23 Township 3N  
County Umatilla Date: 04/28/10

Range 29E

Corner Designation: 3N29N17

Corner common to section 14,15,22 and 23 T3NR29E.

- Condition Report Only
- Not Found
- Remonumented
- Unrecorded
- Surveyed In
- Referenced Out


**Previous Renewals / Surveys, etc.**

Originally Surveyed by Gates in 1859. He set a post in a mound of earth.


**Monuments and Accessories Found: (Condition and Source)**

None.

**Diagram**

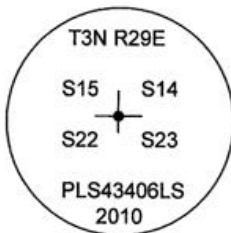

**Sketch**

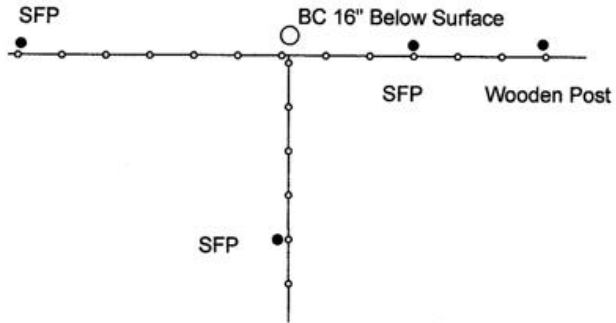

NAD 83/91  
OREGON STATE PLANE NORTH  
INTERNATIONAL FEET

N756385.49  
E8543421.92

LAT - 45° 44' 00.95516" N  
LON - 119° 09' 47.65730" W

**Monument (s) Set (Procedures and Description)**

A 1 1/2" x 30" galvanized iron pipe with a 2 1/2" Brass cap, stamped as shown above. This corner was set at a very old fence corner, which fits dimensionally to the corners West and East of it. This is the apparent best evidence of the corner position, and lines of occupation, that we could find.

**References Set:**

- A 5/8" x 30" Iron rebar w/rpc #43406 lies S 87°30' W, 45.76'.
- A 5/8" x 30" Iron rebar w/rpc #43406 lies S 0°20' W, 61.33'.
- A 5/8" x 30" Iron rebar w/rpc #43406 lies S 86°45' E, 21.86'.
- A 5/8" x 30" Iron rebar w/rpc #43406 lies East, 55.27'.

**Location and Comments**

The corner is 1 mile South and 2 miles West of the intersection of Coppinger Lane and Hwy. 320.

**Compass Declination**

17° E

**Surveyors Seal**

REGISTERED  
PROFESSIONAL  
LAND SURVEYOR

*Robert D. English*  
OREGON  
JANUARY 11, 2005  
ROBERT DOUGLAS ENGLISH  
43406LS

**RECEIVED BY:**

Date: 5-10  
Rec'd By: KK  
No. 10-80-R

**Firm / Agency**

Survey One, LLC.  
P.O. Box 382  
Pendleton, OR 97801  
(541) 276-2055

RENEWAL DATE: 12/31/11