

OREGON CORNER RESTORATION FORM

Section 14 Township 3N
County Umatilla Date: 04/28/10

Range 29E

Corner Designation: 3N29N21

Corner common to section 13,14,23 and 24 T3NR29E.

- Condition Report Only
- Not Found
- Remonumented
- Unrecorded
- Surveyed In
- Referenced Out

Previous Renewals / Surveys, etc.


Originally Surveyed by Gates in 1859. He set a post in a mound of earth.
Wells set a 2 1/2" brass cap 6" up with a mound of dirt at a fence intersection in 1992.

Monuments and Accessories Found: (Condition and Source)


A 2 1/2" Brass cap set by Wells in 1992, stamped as shown below.
A 5/8" Iron rebar w/ypc #1106 lies N 89°15' W, 46.93' with steel fence post.
A 5/8" Iron rebar w/ypc #1106 lies S 3°10' E, 5.56'.
A Brass washer #1106, on a railroad tie fence post, lies S 01°30' W, 71.18'.

Sketch

Diagram

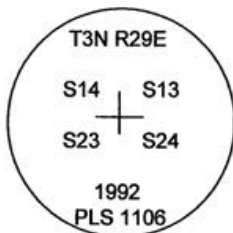

Irrigated Circle

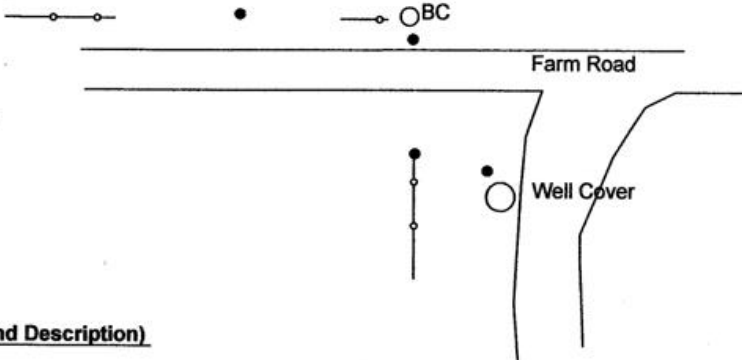

NAD 83/91
OREGON STATE PLANE NORTH
INTERNATIONAL FEET

N756463.61
E8548744.05

LAT - 45° 44' 00.85015" N
LON - 119° 08' 32.61565" W

Monument (s) Set (Procedures and Description)

None.

References Set:

A 5/8" x 30" Iron rebar w/rpc #43406 lies S 07°20' E, 84.50' at North edge of well casing.

Location and Comments

The corner is 1 mile South and 1 mile West of the intersection of Coppinger Lane and Hwy. 320.

Compass Declination

17° E

Surveyors Seal

REGISTERED
PROFESSIONAL
LAND SURVEYOR

Robert D. English
OREGON
JANUARY 11, 2005
ROBERT DOUGLAS ENGLISH
43406LS

RECEIVED BY:

Date: 5-10
Rec'd By: KR
No. 10-822

Firm / Agency

Survey One, LLC.
P.O. Box 382
Pendleton, OR 97801
(541) 276-2055

RENEWAL DATE: 12/31/11