

OREGON CORNER RESTORATION FORM

Section 13,24 Township 3N
County Umatilla Date: 04/28/10

Range 29E

Corner Designation: 3N29N23

Corner common to section 13 and 24 T3NR29E.

_____	Condition Report Only
<u> X </u>	Not Found
<u> X </u>	Remonumented
_____	Unrecorded
<u> X </u>	Surveyed In
<u> X </u>	Referenced Out


Previous Renewals / Surveys, etc.

Originally Surveyed by Gates in 1859. He set a post in a mound of earth.


Monuments and Accessories Found: (Condition and Source)

None. Corner re-established by single proportionate method holding the East-West line between monuments and an ancient North-South fence line. Found decomposed wooden fence post when excavating for the monument. This fence has been in existence and held as apparent lines of occupation for a long time.

Diagram

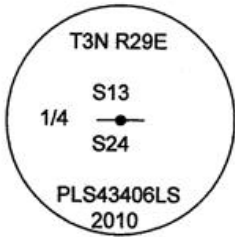

Sketch

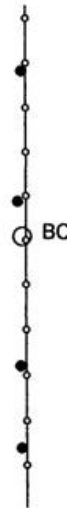

NAD 83/91
OREGON STATE PLANE NORTH
INTERNATIONAL FEET

N756519.00
E8551344.66

LAT - 45° 44' 00.96874" N
LON - 119° 07' 55.94980" W

Monument (s) Set (Procedures and Description)

1 1/2" x 30" galvanized iron pipe with a 2 1/2" brass cap monument, flush with ground, stamped as shown above.

References Set:

- A 5/8" x 30" Iron rebar w/rpc #43406 lies S 02° W, 15.78' at base of wooden fence post.
- A 5/8" x 30" Iron rebar w/rpc #43406 lies S 0° E, 47.44' at base of steel fence post.
- A 5/8" x 30" Iron rebar w/rpc #43406 lies N 0°20' W, 9.90' at base of steel fence post.
- A 5/8" x 30" Iron rebar w/rpc #43406 lies N 0°18' E, 36.27' at base of steel fence post.

Location and Comments

The corner is 1 mile South and 0.5 miles West of the intersection of Coppinger Lane and Hwy. 320.

Compass Declination
17° E

Surveyors Seal

REGISTERED
PROFESSIONAL
LAND SURVEYOR

Robert D. English
OREGON
JANUARY 11, 2005
ROBERT DOUGLAS ENGLISH
434.06LS

RENEWAL DATE: 12/31/11

RECEIVED BY:

Date: 1-11
Rec'd By: KE
No. 11-115-R

Firm / Agency

Survey One, LLC.
P.O. Box 382
Pendleton, OR 97801
(541) 276-2055