

# CORNER RESTORATION FORM

Township 3N Range 29E & 30E Section 13,18,24&19 County UMATILLA

State OREGON Date 9-15-2014 Number N-1  Condition Report Only

Corner Designation : SECTION 13, 18, 24 & 19

- Not Found  
 Renewed  
 Surveyed In  
 Referenced

Previous Renewals ORIGINAL SOURCE OF CORNER

UNDER GLO CONTRACT #84 BY N. GATES DATED  
JULY 22, 1859 SET POST  
   
 

Accessories Found:


NONE

BASIS OF BEARINGS, NAD 83/91 OREGON STATE PLANE  
 COORDINATES NORTH ZONE:

NORTHING: 756579.943  
 EASTING: 8553972.252

### MONUMENT DETAIL

Found  Set

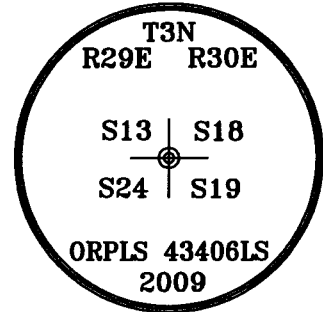

### Monument & Accessories Set (Procedure and Description)

FOUND 2 1/2" BRASS CAP BELOW ROAD GRADE, COVERED WITH A WHITE PIECE OF TIN TO PROTECT THE BRASS CAP. PER SURVEY No. 11-15-R.

### Sketch of Monument, Accessories and General Area

**REGISTERED PROFESSIONAL LAND SURVEYOR**

*Lance Clark King*

**OREGON  
MAY 10, 2011  
LANCE CLARK KING  
61420**

**RENEWS: 6/30/2017**

**Agency:**  
 CK3, LLC  
 945 W. ORCHARD  
 HERMISTON OREGON 97838  
 OFFICE: 541-567-2345  
 FAX: 541-567-2305  
 WEB: CK3ILLC.NET  
 Field Book # 0-298

**COUNTY SURVEYOR  
RECORDING INFO**

Received *Jay Whit*

Filed 6/12/2015

Survey No. 15-050-C

Drawing No. C-853

Index No. N-1