

OREGON CORNER RESTORATION FORM

Section 17,20 Township 3N Range 29E
 County Umatilla Date: 02/17/10

Corner Designation: 3N29N7

Corner common to sections 17 and 20, T3NR29E.

- _____ Condition Report Only
- _____ Not Found
- _____ X _____ Remonumented
- _____ Unrecorded
- _____ X _____ Surveyed In
- _____ X _____ Referenced Out


Previous Renewals / Surveys, etc.

Originally Surveyed by N.H. Gates in 1859. He set a post in a mound of earth.
 Staebler set a 1 x 30" iron pipe w/ 2 1/2" B.C. on survey I-158-B.
 Survey #91-73-C found a Brass cap.


Monuments and Accessories Found: (Condition and Source)

None.

Diagram

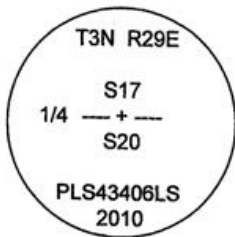

Sketch

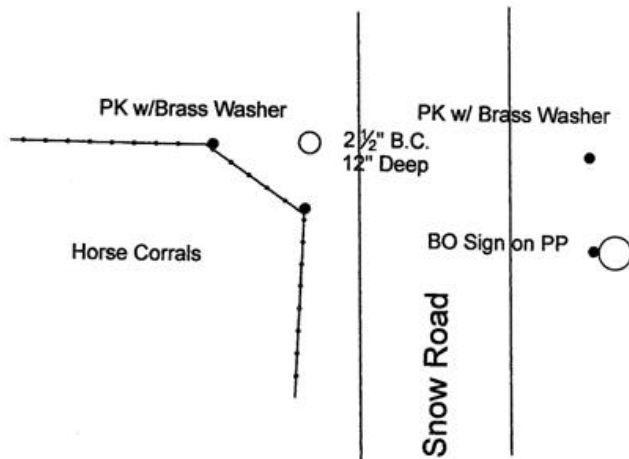

NAD 83/91
 OREGON STATE PLANE NORTH
 INTERNATIONAL FEET
 N756118.19
 E8530135.87
 LAT - 45° 44' 00.44451955" N
 LON - 119° 12' 55.00634062" W

Monument (s) Set (Procedures and Description)

A 2 1/2" Brass cap on 1"x30" Galvanized Iron Pipe 12" deep, near a fence corner. Stamped as shown above.
 Reset from original monument position and Bearing Objects. Badly bent.

References Set:

- A PK nail w/ Brass Washer #43406 lies West, 11.96', on a RR Tie Fence Post.
- A PK nail w/Brass Washer #43406 lies S 5°30' W, 5.18', on a RR Tie Fence Post.
- A PK nail w/ Brass Washer #43406 lies S 88°30' E, 55.90', on a RR Ties Fence Post.
- A B.O. Sign lies S 71°30' E, 62.10', on a Power Pole.

Location and Comments

The corner is .5 miles West of the intersection of Hwy 320 and Snow Road, North of the House in a field.

Compass Declination
 17° E

Surveyors Seal

REGISTERED
 PROFESSIONAL
 LAND SURVEYOR

Robert D. English
 OREGON
 JANUARY 11, 2005
 ROBERT DOUGLAS ENGLISH
 43406LS

RECEIVED BY:

Date: 3-10
 Rec'd By: KK
 No. 10, 31-R

Firm / Agency

Survey One, LLC.
 P.O. Box 382
 Pendleton, OR 97801
 (541) 276-2055

RENEWAL DATE: 12/31/11