

**OREGON CORNER RESTORATION FORM**

Section 17,20  
County Umatilla

Township 3N  
Date: 02/17/10

Range 29E

Corner Designation: 3N29N7

Corner common to sections 17 and 20, T3NR29E.

- Condition Report Only
- Not Found
- Remonumented
- Unrecorded
- Surveyed In
- Referenced Out


**Previous Renewals / Surveys, etc.**

Originally Surveyed by N.H. Gates in 1859. He set a post in a mound of earth.  
Staebler set a 1 x 30" iron pipe w/ 2 1/2" B.C. on survey I-158-B.  
Survey #91-73-C found a Brass cap.


**Monuments and Accessories Found: (Condition and Source)**

None.

**Diagram**

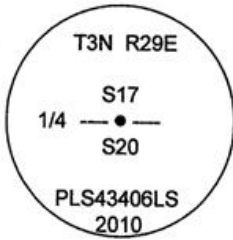

**Sketch**

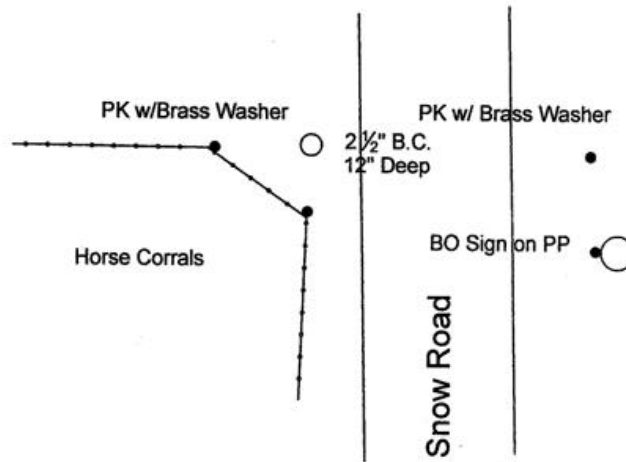

NAD 83/91  
OREGON STATE PLANE NORTH  
INTERNATIONAL FEET

N756113.35  
E8530141.19

LAT - 45° 44' 00.40073" N  
LON - 119° 12' 54.93918" W

**Monument (s) Set (Procedures and Description)**

A 1 1/4"x30" galvanized iron pipe with a 2 1/2" brass cap, 12" below surface, near a fence corner. Stamped as shown above.  
Reset from original monument position and Bearing Objects. Badly bent.

**References Set:**

- A PK nail w/ Brass Washer #43406 lies West, 11.96', on a RR Tie Fence Post.
- A PK nail w/Brass Washer #43406 lies S 5°30' W, 5.18', on a RR Tie Fence Post.
- A PK nail w/ Brass Washer #43406 lies S 88°30' E, 55.90', on a RR Ties Fence Post.
- A B.O. Sign lies S 71°30' E, 62.10', on a Power Pole.

**Location and Comments**

The corner is .5 miles West of the intersection of Hwy 320 and Snow Road, North of the House in a field.

**Compass Declination**  
17° E

**Surveyors Seal**

REGISTERED  
PROFESSIONAL  
LAND SURVEYOR

*Robert D. English*  
OREGON  
JANUARY 11, 2005  
ROBERT DOUGLAS ENGLISH  
43406LS

**RECEIVED BY:**

Date: 1-11  
Rec'd By: KR  
No. 11-15-R

**Firm / Agency**

Survey One, LLC.  
P.O. Box 382  
Pendleton, OR 97801  
(541) 276-2055

RENEWAL DATE: 12/31/11