

**OREGON CORNER RESTORATION FORM**

Section 24 Township 3N Range 29E  
County Umatilla Date: 08/18/09

Corner Designation: 3N29P25

1/4 Corner common to section 24, T3NR29E, and section 19, T3NR30E.

- Condition Report Only
- Not Found
- Remonumented
- Unrecorded
- Surveyed In
- Referenced Out


**Previous Renewals / Surveys, etc.**

Originally Surveyed by David P. Thompson in 1859. He set a post in a mound of earth.

**Monuments and Accessories Found: (Condition and Source)**

None

Diagram

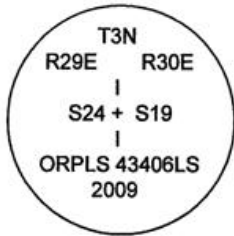


NAD 83/91  
OREGON STATE PLANE NORTH  
INTERNATIONAL FEET

N753936.93  
E8554003.65

LAT - 45° 43' 35.045589" N  
LON - 119° 07' 18.846968" W

Sketch

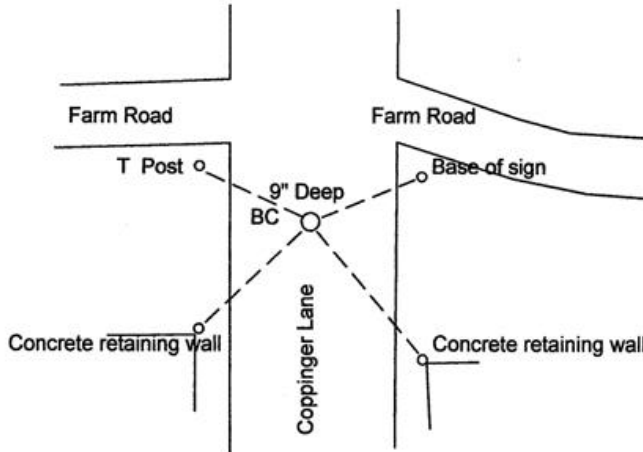

**Monument (s) Set (Procedures and Description)**

Set A 1"x30" flared galvanized iron pipe with a 2 1/2" B.C. by best fit between the northeast corner of the township and the northeast corner of S 25 and the East-West field lines.

**References Set:**

- A 5/8" x 30" Iron rebar w/ypc #43406 lies N 56°45' E, 30.38'
- A 5/8" x 30" Iron rebar w/ypc #43406 lies S 30°15' E, 89.79'.
- A 5/8" x 30" Iron rebar w/ypc #43406 lies S 39°45' W, 41.31'.
- A 5/8" X30" Iron rebar w/ypc #43406 lies N 65°00' W, 29.10'.

**Location and Comments**

The corner is 1.5 miles south of the intersection of Coppinger Lane and Highway 320.

**Compass Declination**  
17° E

**Surveyors Seal**

REGISTERED  
PROFESSIONAL  
LAND SURVEYOR

*Robert D. English*  
OREGON  
JANUARY 11, 2005  
ROBERT DOUGLAS ENGLISH  
43406LS

**RECEIVED BY:**

Date: 8-09  
Rec'd By: RE  
No. 09-122-R

**Firm / Agency**

Survey One, LLC.  
P.O. Box 382  
Pendleton, OR 97801  
(541) 276-2055

RENEWAL DATE: 12/31/09