

OREGON CORNER RESTORATION FORM

Section 20 Township 3N
County Umatilla Date: 02/17/10

Range 29E

Corner Designation: 3N29P7

Center 1/4 common to sections 17, T3NR29E.

Condition Report Only
 Not Found
 Remonumented
 Unrecorded
 Surveyed In
 Referenced Out


Previous Renewals / Surveys, etc.

Originally Surveyed by N.H. Gates in 1859. He set a post in a mound of earth.
Survey #I-158-B set a Brass cap.

Monuments and Accessories Found: (Condition and Source)


A 2 1/2" Brass Cap 21" Below the surface.

Diagram

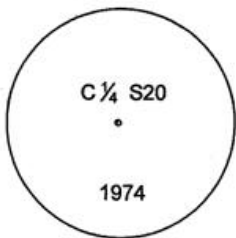

Sketch

Snow Road

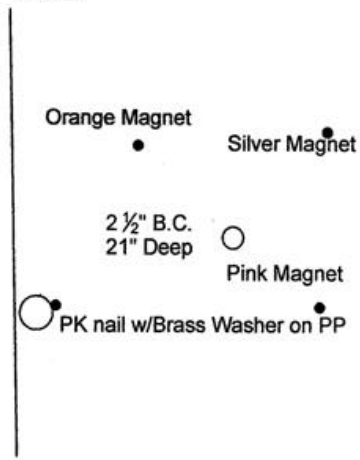

NAD 83/91
OREGON STATE PLANE NORTH
INTERNATIONAL FEET

N753439.98
E8530198.85

LAT - 45° 43' 34.00080" N
LON - 119° 12' 54.72574" W

Monument (s) Set (Procedures and Description)

None.

References Set: "Deep One" magnets by Bernsten.

A Pink magnet lies S 64°20' E, 16.08', 18" deep.
A Silver Magnet lies N 42°00' E, 20.09', 18" deep.
An Orange Magnet lies N 38°00' W, 18.20', 18" deep.
A PK nail w/Brass Washer #43406 lies S 78°30' W, 32.03', on a Power Pole.

Location and Comments

The corner is 1.25 miles South of
the intersection of Hwy 320
and Snow Road.

Compass Declination
17° E

Surveyors Seal

REGISTERED
PROFESSIONAL
LAND SURVEYOR

Robert D. English
OREGON
JANUARY 11, 2005
ROBERT DOUGLAS ENGLISH
43406LS

RECEIVED BY:

Firm / Agency

Date: 1-11
Rec'd By: KK
No. 11-16-2

Survey One, LLC.
P.O. Box 382
Pendleton, OR 97801
(541) 276-2055

RENEWAL DATE: 12/31/11