

**OREGON CORNER RESTORATION FORM**

Section 30,31 Township 3N  
County Umatilla Date: 3/5/10

Range 29E

Corner Designation: 3N29V3

1/4 Corner common to sections 30,31 T3NR29E.

- Condition Report Only
- Not Found
- Remonumented
- Unrecorded
- Surveyed In
- Referenced Out


**Previous Renewals / Surveys, etc.**

Originally Surveyed by Gates in 1859. He set a post in a mound of earth.


**Monuments and Accessories Found: (Condition and Source)**

Found pyramidally shaped stone, similar to others found near Harris's monuments, at fence corner.

**Diagram**

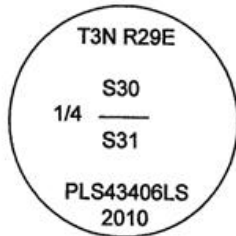

**Sketch**

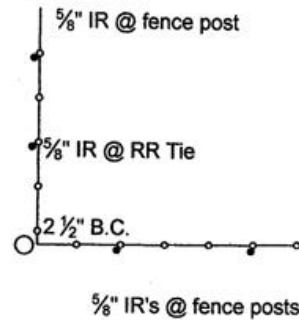

NAD 83/91  
OREGON STATE PLANE NORTH  
INTERNATIONAL FEET

N745309.36  
E8525060.73

LAT - 45° 42' 14.532375" N  
LON - 119° 14' 08.933423" W

**Monument (s) Set (Procedures and Description)**

Set a 1 1/8" x 30" galvanized iron pipe with a 2 1/2" Brass cap, flush with ground, at a found stone and an old fence corner. Buried stone alongside monument. Cap marked as shown above.

**References Set:**

- A 5/8" Iron rebar w/ypc #43406 at a steel fence post, lies S 89°30' E, 39.85'.
- A 5/8" Iron rebar w/ypc #43406 at a steel fence post, lies S 88°20' E, 22.78'.
- A 5/8" Iron rebar w/ypc #43406 at a RR Tie fence post, lies N 2°15' E, 26.69'.
- A 5/8" Iron rebar w/ypc #43406 at a steel fence post, lies N 2° E, 50.09'.

**Location and Comments**

From the intersection of Hwy. 320 and Snow Road, go 2.2 miles South, and 1 mile West along the fence.

**Compass Declination**

17° E

**Surveyors Seal**

REGISTERED  
PROFESSIONAL  
LAND SURVEYOR

*Robert D. English*  
OREGON  
JANUARY II, 2005  
ROBERT DOUGLAS ENGLISH  
43406LS

**RECEIVED BY:**

Date: 3-10  
Rec'd By: KE  
No. 10-42-R

**Firm / Agency**

Survey One, LLC.  
P.O. Box 382  
Pendleton, OR 97801  
(541) 276-2055

RENEWAL DATE: 12/31/11