

OREGON CORNER RESTORATION FORM

Section 35,36

Township 3N

Range 29E

County Umatilla

Date: 03/08/10

Corner Designation: 3N29Z21

Corner common to Sections 35,36 T3NR29E, and 1,2 T2NR29E.

- Condition Report Only
- Not Found
- Remonumented
- Unrecorded
- Surveyed In
- Referenced Out


Previous Renewals / Surveys, etc.

Originally Surveyed by David P. Thompson. He set a post in a mound of earth in 1859.


Monuments and Accessories Found: (Condition and Source)

None.

Diagram

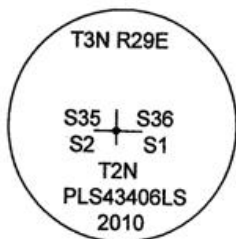

Sketch

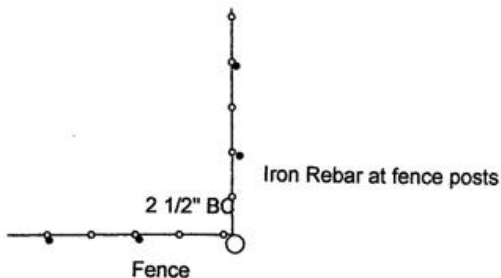

NAD 83/91
OREGON STATE PLANE NORTH
INTERNATIONAL FEET

N740603.22
E8549007.53

LAT - 45° 41' 24.24308" N
LON - 119° 08' 32.66551" W

Monument (s) Set (Procedures and Description)

Set a 1 1/4" X 30" galvanized iron pipe with a 2 1/2" brass cap, flush with ground at a fence corner which fits record distances very closely. Cap marked as shown above.

References Set: set rebar by fence posts for ease of re-locating and protection.

- A 5/8"x30" Iron rebar w/ypc #43406 lies N 3°30' E, 52.00'.
- A 5/8"x30" Iron rebar w/ypc #43406 lies N 3°15' E, 23.73'.
- A 5/8"x30" Iron rebar w/ypc #43406 lies N 85° W, 22.25'.
- A 5/8"x30" Iron rebar w/ypc #43406 lies N 85°45' W, 53.25'.

Location and Comments

The corner is 3.5 miles East of the cattle guard at the South end of Snow Road along the East-West fence. Getting to this corner is challenging at best.

Compass Declination
17° E

Surveyors Seal

REGISTERED
PROFESSIONAL
LAND SURVEYOR

Robert D. English
OREGON
JANUARY 11, 2005
ROBERT DOUGLAS ENGLISH
43406LS

RECEIVED BY:

Date: 1-11
Rec'd By: *[Signature]*
No. 11-21-R

Firm / Agency

Survey One, LLC.
P.O. Box 382
Pendleton, OR 97801
(541) 276-2055

RENEWAL DATE: 12/31/11