

OREGON CORNER RESTORATION FORM

Section 31 Township 3N
County Umatilla Date: 04/23/10

Range 29E

Corner Designation: 3N29Z3

Corner common to sections 31 T3NR29E, 6 T3NR28E.

Condition Report Only
 Not Found
 Remonumented
 Unrecorded
 Surveyed In
 Referenced Out


Previous Renewals / Surveys, etc.

Originally Surveyed by David P. Thompson. He set a post in a mound of earth in 1859.


Monuments and Accessories Found: (Condition and Source)

None.

Diagram

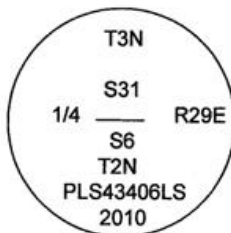

Sketch

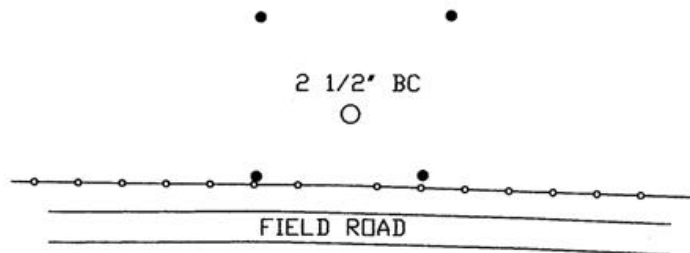

NAD 83/91
OREGON STATE PLANE NORTH
INTERNATIONAL FEET

N739937.05
E8525058.83
LAT - 45° 41' 21.49777" N
LON - 119° 14' 10.144527" W

Monument (s) Set (Procedures and Description)

A 1 1/2" x 30" Galvanized iron pipe w/ a 2 1/2" Brass Cap, 20" below surface, stamped as shown above.

References Set: Deep One Magnets by Berntsen.

- A "x30" Iron rebar w/rpc 43406LS lies S 38°45' E, 30.72', at base of steel fence post.
- A 5/8"x30" Iron rebar w/rpc 43406LS lies S 28°20' W, 28.18', at base of steel fence post.
- An Orange magnet, 14" deep, lies N 39°00' W, 15.66'.
- A Silver magnet, 14" deep, lies N 40°00' E, 16.46'.

Location and Comments

The corner is 1 mile West of the South end of Snow road along a field road.

Compass Declination

17° E

Surveyors Seal

REGISTERED
PROFESSIONAL
LAND SURVEYOR

Robert D. English
OREGON
JANUARY II, 2005
ROBERT DOUGLAS ENGLISH
43406LS

RECEIVED BY:

Date: 5-10
Rec'd By: KK
No. 10-87-R

Firm / Agency

Survey One, LLC.
P.O. Box 382
Pendleton, OR 97801
(541) 276-2055

RENEWAL DATE: 12/31/11