

# OREGON CORNER RESTORATION FORM

COUNTY: Umatilla DATE: 7/16/2013

CORNER DESIGNATION: 3N32, A05, The Northwest Corner of Section 5.

PREVIOUS RENEWALS/SURVEYS ETC.: Corner originally established by David Thompson under Contract 106, dated August 1864, notes state: Set post for corner to Secs. 5, 6, 31 & 32 in mound of Earth with charred stake, pits, trench, as per instructions.

MONUMENT AND ACCESSORIES FOUND: None.

## MONUMENT MARKING DETAIL:

T4N R32E  
S31|S32  
S6 | S5  
T3N  
2013  
PLS 54657

MONUMENT SET: Held mid-point between the North one-quarter corner positions of Sections 5 and 6 and the centerline of the existing County Road centerline for latitude. At said reestablished corner point, set a 2 3/8" brass cap on a 1 1/4" x 30" galvanized iron pipe with top 10" below ground level, stamped as marked in "Monument Marking Detail".

From which:

A 5/8" x 24" iron rod with a 1 1/4" purple plastic cap stamped "Wells Surveying PLS 54657" in road bank bears North 57° East, 31.5 feet.

A 5/8" x 24" iron rod with a 1 1/4" purple plastic cap stamped "Wells Surveying, PLS 54657" in road bank bears South 60 1/2° East, 39.7 feet.

A 5/8" x 24" iron rod with a 1 1/4" purple plastic cap stamped "Wells Surveying, PLS 54657" in road bank bears South 57 1/2° West, 35.4 feet.

A 5/8" x 24" iron rod with a 1 1/4" purple plastic cap stamped "Wells Surveying, PLS 54657" in road bank bears North 60° West, 35.4 feet.

Attached bearing object tags to rebar accessories.

LOCATION AND COMMENTS: Corner falls in County Road.

OREGON STATE PLANE COORDINATE, North Zone, NAD 83(91), International Feet:

N= 773363.06'  
E= 8623318.80'


FIRM: Wells Surveying  
P.O. Box 1696  
Pendleton, OR 97801

COMPASS DECLINATION: 18° East

Surveyor's Seal

Witnesses: Jason Wells, PLS  
Dean Roy

\3N32A05

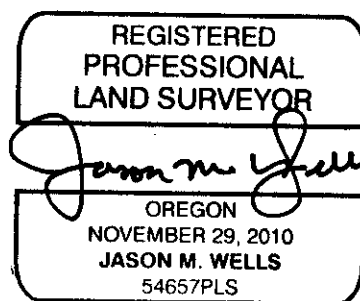

RENEWS 6-30-14