

OREGON CORNER RESTORATION FORM

Section: 1, 6 Township: 3N Range: 32E, 33E
County: Umatilla Date: 3/14/2011

Corner Designation: 3N33C01 (Amended 3/30/2012)

Quarter corner common to Sections 1, T3NR32E; 6, T3NR33E.

_____	Condition Report Only
X	Not Found
X	Remonumented
_____	Unrecorded
X	Surveyed In
X	Referenced Out


Previous Renewals / Surveys, etc.

Originally surveyed by Thompson in 1864. He set a post in a mound of earth, with charred stake, pits, and a trench.


Monuments and Accessories Found: (Condition and Source):

None.

Diagram

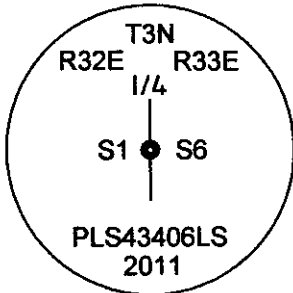

Sketch

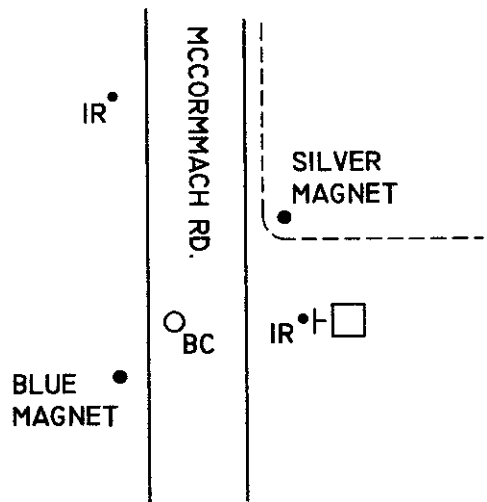

NAD 83/91
OREGON STATE PLANE NORTH
INTERNATIONAL FEET

N771240.11
E8649833.27

Monument(s) Set (Procedures and Description):

A 1 1/8" x 30" galvanized iron pipe with 2 1/2" brass cap, stamped as shown above, 1.5' below the surface. The corner location was reestablished at the intersection of the line between neighboring corners North and South and the projection of a field line from the East.

References Set:

- "Deep One" magnets by Berntsen.
- A 5/8" x 30" iron rebar w/RPC #43406 lies N 12° 20' W, 60.80', at a power pole.
- A silver magnet lies N 48° 30' E, 40.87', 1.7' deep.
- A 5/8" x 30" iron rebar w/RPC #43406 with a steel fence post lies N 88° 50' E, 34.86', with a steel fence post, at an old juniper fence corner post.
- A blue magnet lies S 43° 50' W, 18.08', 1.7' deep.

Location and Comments:

The corner is located 1/2 mile South of the intersection of Midway Rd. and McCormmach Rd., in the Southbound lane of McCormmach Rd.

Compass Declination

17° E

Surveyors Seal

REGISTERED
PROFESSIONAL
LAND SURVEYOR

Robert D. English
OREGON
JANUARY 11, 2005
ROBERT DOUGLAS ENGLISH
43406LS

RECEIVED BY:

Date: 7/10/2012
Rec'd By: [Signature]
No. 12-094-C

Firm / Agency

Survey One, LLC.
P.O. Box 382
Pendleton, OR 97801
(541) 276-2055

RENEWAL DATE: 12/31/13