

**OREGON CORNER RESTORATION FORM**

COUNTY: Umatilla DATE: 08/15/13

CORNER DESIGNATION: 3N32, E23, The North One-Quarter Corner of Section 12.

PREVIOUS RENEWALS/SURVEYS ETC.: Corner originally established by David Chaplin, under Contract 107, dated September 1864, notes state: Set post for 1/4 Sec. cor. in mound of Earth with charred stake pits & c as per instructions.

MONUMENT AND ACCESSORIES FOUND: None.

MONUMENT MARKING DETAIL:

T3N R32E  
1 S1  
4 S12  
2013  
PLS 54657

MONUMENT SET: Held a point 1 foot West of a railroad tie field marker, with field berms extending North, East, and West as the best available evidence of the original corner location. At the reestablished corner point, set a 2 3/8" brass cap on a 1 1/4" x 30" galvanized iron pipe with top flush with ground stamped as marked in "Monument Marking Detail", from which:  
A silver deep-1 magnet, 20" below ground surface, bears North 47° East, 41.4 feet.  
A pink deep-1 magnet, 20" below ground surface, bears South 52° East, 40.0 feet.  
A blue deep-1 magnet, 20" below ground surface, bears South 36 1/2° West, 38.7 feet.  
An orange deep-1 magnet, 20" below ground surface, bears North 52° West, 39.3 feet.  
Buried bearing object tags with magnets, nailed witness post sign on railroad tie post.

LOCATION AND COMMENTS: Located at the intersection with field berms North, East, and West.


OREGON STATE PLANE COORDINATE, North Zone, NAD 83(91), International Feet:

N= 768536.56'  
E= 8647216.77'

FIRM: Wells Surveying  
P.O. Box 1696  
Pendleton, OR 97801

COMPASS DECLINATION: 18° East Surveyor's Seal

Witnesses: Jason Wells, PLS  
Dean Roy  
\3N32E23

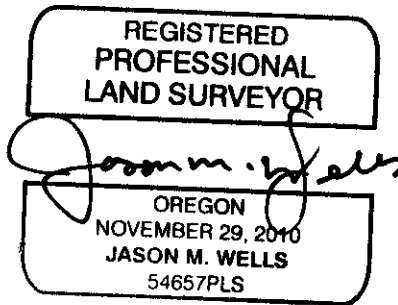

RENEWS: 6-30-14