

OREGON CORNER RESTORATION FORM

Section: 6
Township: 3 North
Range: 33 East of the Willamette Meridian
County: Umatilla
Date: 07/24/02

Corner Indexing Information: Township 3N Range 33E Corner Code ~~A~~-1 (Willamette Meridian)

Additional Identifier: (e.g. BLM designation for the corner, street intersection, plat name, block, lot, etc.)

Southwest corner Section 6

Oregon Plane Coordinates: N: 768606.281 E: 8649882.819

Zone: North Order: second Datum: NAD83-91 Convergence: 1°14'39.7" Scale Factor: 0.99986553

Previous Renewals/Surveys, etc.:


This corner was originally established by Thompson in 1864 as a post, charred stake, mound, and pits, per contract no. 106. In 1971, Staebler found a charred stake in the road and set a 5/8" rebar with brass cap witness corners to the Northeast and Southwest. (C.S. H-179)

Monument(s) & Accessories Found (Condition & Source):

Found a 5/8" rebar 12" deep in North-South road. Brass cap and pipe to Northeast leaning against field berm. Witness corner to Southwest I good condition.

Monument Set (Procedures & Description):

Monument Detail:

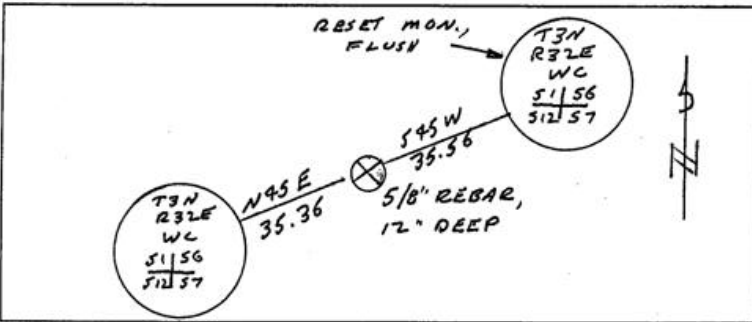

Location & Comments:

Compass Declination:

19° East

Surveyor's Seal

Firm/Agency: Tomkins Land Surveying, Inc.
20 E. Poplar, Suite 204
Walla Walla WA 99362

REGISTERED
PROFESSIONAL
LAND SURVEYOR

Paul W. P. Tomkins

OREGON
JULY 26, 1988
PAUL W. P. TOMKINS
2360

Party Chief: PWPT

Notes:

Witness:

*renews 6/30/04
2/11/03*

RECEIVED BY

Umatilla County Surveyor

Date 2-03

Rec'd By JK

No. 03-25-9