

OREGON CORNER RESTORATION FORM

Section: 12, 7 Township: 3N Range: 32E, 33E
County: Umatilla Date: 3/10/2011

Corner Designation: 3N33G01 (Amended 3/28/2012)

Quarter corner common to Sections 12, T3NR32E; 7, T3NR33E.

_____	Condition Report Only
<u> X </u>	Not Found
<u> X </u>	Remonumented
_____	Unrecorded
<u> X </u>	Surveyed In
<u> X </u>	Referenced Out


Previous Renewals / Surveys, etc.

Originally surveyed by Thompson in 1864. He set a post in a mound of earth. In 2006 Haddock held the intersection of the projected road centerline and the plow berm to the west to be the corner location.


Monuments and Accessories Found: (Condition and Source):

None.

Diagram

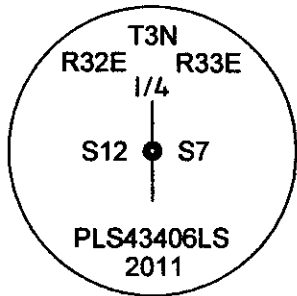

Sketch

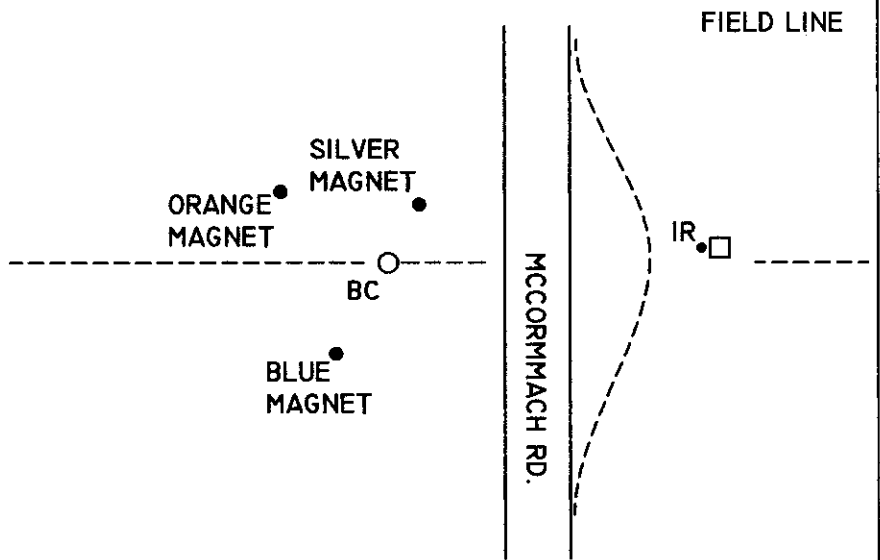

NAD 83/91
OREGON STATE PLANE NORTH
INTERNATIONAL FEET

N765956.92
E8649936.40

Monument(s) Set (Procedures and Description):

A 1 1/8" x 30" galvanized iron pipe with a 2 1/2" brass cap, stamped as shown above, 1.8' below the surface. The corner location was reestablished by single proportionate method for Easting and by holding the old fence post at the field intersection next to the road as best evidence for Northing. Corner posts have been common in this area.

References Set:

- "Deep One" magnets by Berntsen.
- An orange magnet lies N 58° 30' W, 28.42', 1.7' deep.
- A silver magnet lies N 32° 30' E, 23.63', 1.7' deep.
- A 5/8" x 30" iron rebar w/RPC #43406 lies N 89° 50' E, 85.57'.
- A blue magnet lies S 30° W, 35.31', 1.9' deep.

Location and Comments:

The corner is located 1/2 mile North of the intersection of Shafer Rd. and McCormach Rd.

Compass Declination

17° E

Surveyors Seal

REGISTERED
PROFESSIONAL
LAND SURVEYOR

Robert D. English

OREGON
JANUARY 11, 2005
ROBERT DOUGLAS ENGLISH
43406LS

RENEWAL DATE: 12/31/13

RECEIVED BY:

Date: 7/10/2012
Rec'd By: S. Pres
No. 12-094-C

Firm / Agency

Survey One, LLC.
P.O. Box 382
Pendleton, OR 97801
(541) 276-2055