

OREGON CORNER RESTORATION FORM

COUNTY: Umatilla DATE: 08/19/13

CORNER DESIGNATION: 3N32, G09, The West One-Quarter Corner of Section 9.

PREVIOUS RENEWALS/SURVEYS ETC.: Corner originally established by David Chaplin, under Contract 107, dated September 1864, notes state: Set post for 1/4 Sec. cor. in mound of Earth with charred stake pits & c as per instructions.

MONUMENT AND ACCESSORIES FOUND: None.

MONUMENT MARKING DETAIL:

T3N R32E
1/4
S8 | S9
2013
PLS 54657

MONUMENT SET: Reestablished corner at held point on line between the Southeast and Northeast corners of Section 8 at its intersection with a East-West Field berm as best available evidence of the original corner location. At calculated point, set a 2 3/8" brass cap on a 1 1/4" x 30" galvanized iron pipe with top 20" below ground level marked as shown in "Monument Marking Detail", from which:

- A silver deep-1 magnet buried 20" in the ground bears North 62° East, 31.6 feet.
 - A pink deep-1 magnet buried 20" in the ground bears South 39° East, 35.2 feet.
 - A blue deep-1 magnet buried 20" in the ground bears South 60 1/2° West, 42.8 feet.
 - An orange deep-1 magnet buried 20" in the ground bears North 39 1/2° West, 40.9 feet.
- Buried bearing object tags with magnets.

LOCATION AND COMMENTS: Located in an East-West field berm.

OREGON STATE PLANE COORDINATE, North Zone, NAD 83(91), International Feet:


N= 765472.02'
E= 8628761.96'

FIRM: Wells Surveying
P.O. Box 1696
Pendleton, OR 97801

COMPASS DECLINATION: 18° East

Surveyor's Seal

Witnesses: Jason Wells, PLS
Dean Roy
3N32G09

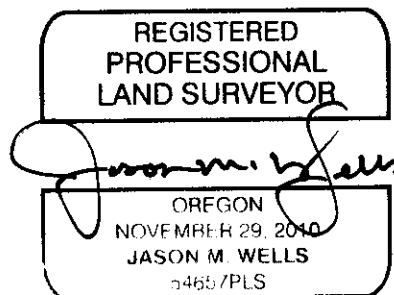

RENEWS: 6-30-14