


OREGON CORNER RELOCATION FORM

Section 27 Township 3N Range 32E
 County Umatilla Date: August 14, 1997

Corner Designation: 3N32R17 Condition Report Only
 Not found
 Section corner common to sections 22, 23, 26, and x Remonumented
 27 T3N, R32E, W.M. x Unrecorded
 Surveyed in
x Referenced out

Previous Renewals / Surveys, etc.
 Corner originally set by Daniel Chaplin under contract No. 107 Dated September 21, 1864.
 His record reads: Set post for corner to Sec.s 22, 23, 26, & 27 in mound of earth with charred stake , pits and C as per instructions.

Monument and Accessories found: (condition and source)
 Railroad tie and plow lines running east, west, and south.

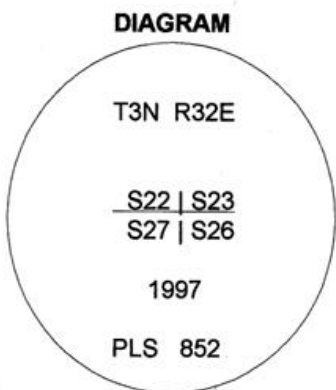

MONUMENT (S) AND ACCESSORIES SET (Procedures and Description)
 Set a 2 1/2" Brass cap on a 1 1/4"x30" galvanized iron pipe 29" in the ground on the west side of the railroad tie at the intersection of the plow lines. The position agrees very well with the identified corners 3N32R13 and 3N32Z17 in distance from those corners.

For references, I set four 5/8" by 24" rebars with 1.25" red plastic caps stamped ORLS 852 and WAL5 13922 2' below the surface in plowed fields as described below:
 a rebar bears N87°20'W, 16.30 feet;
 a rebar bears N01°26'W, 16.55 feet;
 a rebar bears N89°25'E, 15.94 feet;
 a rebar bears S00°52'E, 17.67 feet;

The monument was surveyed and references tied using Two wild System 200 GPS receivers.

Location and comments
 Witnessed by Mathew Severe

Compass Declination

Surveyors Seal

RECEIVED BY:
Umatilla County Surveyor
 Date: 9-97
 Rec'd By: KK
 No. 97-172-B

Firm / Agency
 Haddock Surveying
 Address
 P.O. Box 1574
 Pendleton, Or. 97801
 Party Chief
 Stephen K, Haddock

REGISTERED
 PROFESSIONAL
 LAND SURVEYOR
David L. Haddock
 OREGON
 JULY 12, 1906
 DAVID L. HADDOCK
 652