

# OREGON CORNER RESTORATION FORM

COUNTY: Umatilla DATE: 08/15/13

CORNER DESIGNATION: 3N32, R03, The North One-Quarter Corner of Section 30.

PREVIOUS RENEWALS/SURVEYS ETC.: Corner originally established by David Chaplin, under Contract 107, dated September 1864, notes state: Set post for 1/4 Sec. cor. in mound of Earth with charred stake pits & c as per instructions. F.B. Hayes, in his undated Survey No. Q-521-C, states he set a 1" I.P. John Shea, in his Survey No. 12-126-B, calculated a position for this corner by single proportion measure but no monument was set.

MONUMENT AND ACCESSORIES FOUND: None. The record corner monument was thoroughly searched on Survey No. 06-462-C. The I.P. set 1/4 mile to the North was found, a 1" iron pipe, in 2006, but it is removed from the ground and lying flat.

## MONUMENT MARKING DETAIL:

T3N R32E

1 S19

4 S30

2013

PLS 54657

MONUMENT SET: Reestablished corner at held intersection of field berms North and East as the best remaining evidence of the original corner position and set a 5/8" x 24" iron rod with a 2" aluminum cap, buried 20" below ground level, stamped as shown in "Monument Marking Detail", from which:

A silver deep-1 magnet, 20" below ground surface, bears North 38° East, 40.4 feet.

A pink deep-1 magnet, 20" below ground surface, bears South 38 1/2° East, 40.3 feet.

A blue deep-1 magnet, 20" below ground surface, bears South 37 1/2° West, 43.3 feet.

An orange deep-1 magnet, 20" below ground surface, bears North 39° West, 39.2 feet.

Buried bearing object tags with magnets.

LOCATION AND COMMENTS: Located at a point with field berms North and East.

OREGON STATE PLANE COORDINATE, North Zone, NAD 83(91), International Feet:

N= 752117.27'

E= 8621120.90'


FIRM: Wells Surveying  
P.O. Box 1696  
Pendleton, OR 97801

COMPASS DECLINATION: 18° East

Surveyor's Seal

Witnesses: Jason Wells, PLS  
Dean Roy

\3N32R03

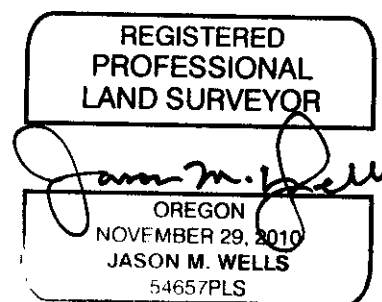

RENEWS: 6-30-14