

OREGON CORNER RESTORATION FORM

Section 31 Township 3N Range 33E
 County Umatilla Date: May 5, 2001

Corner Designation: 3N33V1

Corner to sections 30 and 31 R33E, and 25 and 36, R32E,
 W.M., Umatilla County, Oregon.


Previous Renewals / Surveys, etc.

Corner originally set by David P. Thompson under contract #106 dated August 16, 1864.

His record reads: Set post for corner to secs. 30, 31, 25, & 36 in mound of earth with charred stak
 pits, trench & c. as per instructions.

Monument and Accessories found: (condition and source)

Plow berms extend east and west from this point. There is a post and other evidence near the
 end of the plow berm to the west which indicate that the berm has not moved for a long time. The
 resulting west section line for Section 31 is within 8 feet of Kimbrell's record distance.

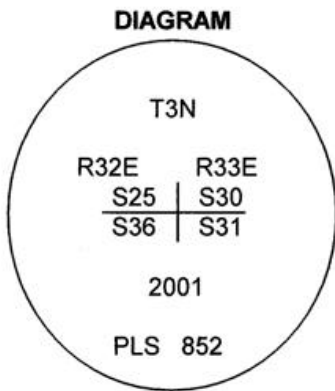

A hand-drawn sketch of the corner location. A vertical dashed line is labeled 'McCormach Road'. To the west of the road is a 'Plow Berm' with a square marker. To the east is another 'Plow Berm' with a circle marker containing a dot. A 'Driveway' is shown with a dashed line leading to a 'Culvert'. A legend indicates: a dot is a 5/8" Rebar, a square is a Line marker post, a circle with a dot is a Brass Cap, and a square with a dot is a Guard Post. A north arrow is in the top right.

MONUMENT (S) AND ACCESSORIES SET (Procedures and Description)

Set a 1 1/2" x 30" galvanized iron pipe with a 2 1/4" brass cap stamped as shown in the diagram
 above at the intersection of the township line with the east - west plow berms. Set a 6 foot steel
 fence post with a County monument sign attached along side. Burried a clear, Deep 1, magnetic
 marker at the corner point below the brass cap.

For references, I set four, 5/8" by 24" rebars with 1.25" red plastic caps stamped ORLS 852 and
 WAL5 13922 as described below:

- an iron rebar bears N68°09'26"W, 48.73 feet 1 foot below the surface;
- an iron rebar bears N51°52'14"E, 15.75 feet 2 feet below the surface in a plowed field;
- an iron rebar bears S63°58'48"W, 51.58 feet 1 foot below the surface;
- an iron rebar bears S47°30'39"E, 34.85 feet 18" below the surface;

The monument and references were tied using a LIECA system 300 RTK GPS.

Location and comments

Compass Declination

Surveyors Seal

RECEIVED BY:
 Umatilla County Surveyor
 Date: 6-04
 Rec'd By: [Signature]
 No. 01-81-C

Firm / Agency
 Haddock Surveying
 Address
 P.O. Box 1574
 Pendleton, Or. 97801
 Party Chief
 Stephen K, Haddock

