

OREGON CORNER RESTORATION FORM

COUNTY: Umatilla DATE: 04/30/13

CORNER DESIGNATION: 3N32, V05, The Northwest Corner of Section 32.

PREVIOUS RENEWALS/SURVEYS ETC.: Corner originally established by David Chaplin, under GLO Contract dated September 1864, notes state: Set post for corner to Secs. 29, 30, 31 & 32 in mound of Earth with charred stake, pits, & as per instructions. Corner reestablished by John Kimbrell, 1906, Record of Private Survey Book 1 Page 580, record states "set stake for cor of Secs 29-30-31 and 32." The City Pendleton has acquired use of the Airport area and has made a number of surveys for fencing purposes and GLO corner location, including Survey No. 89-123-B. It is believed the U.S. Army made surveys when the Pendleton Airbase was constructed, but no boundary survey information has ever been found.

MONUMENT AND ACCESSORIES FOUND: None.

MONUMENT MARKING DETAIL:

T3N R32E
S30|S29
S31|S32
2013
PLS 54657

MONUMENT SET: Corner position was re-established by holding the Southerly projection of the centerline of Daniel Road, holding the deed distance of 360 feet South of an old fence corner marking an angle point in Airport property. It should be noted said fence corner is not on section line but is on the approximate Southerly projected East right-of-way line of Daniel Road. At the reestablished corner position, set a 2 3/8" brass cap on a 1 1/4" x 30" galvanized iron pipe with top 18" below ground level in farmed field marked as shown in "Monument Marking Detail", from which:

- A silver deep-1 magnet, buried 20" below surface, bears North 55 1/2° East, 26.1 feet.
 - A purple deep-1 magnet, buried 20" below surface, bears South 42° East, 29.4 feet.
 - A blue deep-1 magnet, buried 20" below surface, bears South 36° West, 29.2 feet.
 - An orange deep-1 magnet, buried 20" below surface, bears North 44° West, 24.3 feet.
- Attached bearing object tags to all magnets.

LOCATION AND COMMENTS: Located 360 feet South of a fence old fence corner inside the Pendleton Airport. A fence corner with fences North and East is 1.0 feet North of monument.

OREGON STATE PLANE COORDINATE, North Zone, NAD 83(91), International Feet:

N= 746898.86'
E= 8623894.05'


FIRM: Wells Surveying
P.O. Box 1696
Pendleton, OR 97801

COMPASS DECLINATION: 18° East

Surveyor's Seal

Witnesses: Jason Wells, PLS
Dean Roy

\3N32V05

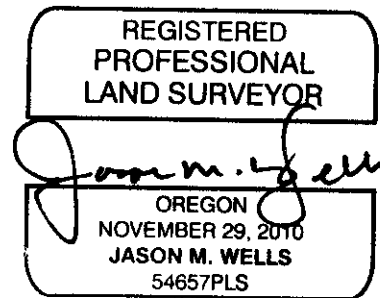

RENEWS: 6-30-14