

OREGON CORNER RESTORATION FORM

Section: 2, 35 Township: 3N, 4N Range: 33E
County: Umatilla Date: 3/25/2011

Corner Designation: 3N33A19 (Amended 4/3/2012)

Quarter corner common to Sections 2, T3NR33E; 35, T4NR33E.

<input checked="" type="checkbox"/>	Condition Report Only
<input type="checkbox"/>	Not Found
<input type="checkbox"/>	Remonumented
<input type="checkbox"/>	Unrecorded
<input type="checkbox"/>	Surveyed In
<input checked="" type="checkbox"/>	Referenced Out


Previous Renewals / Surveys, etc.

Originally surveyed by Thompson in 1864. He set a post in a mound of earth with charred stake, pits, and trench. In 1976 Krumbein set a brass cap in Survey M-121-C.


Monuments and Accessories Found: (Condition and Source):

A 2 1/2" brass cap, stamped as shown below, 4" below the surface.
A 5/8" iron rebar lies N 43° 40' E, 41.73', at a power pole.

Diagram

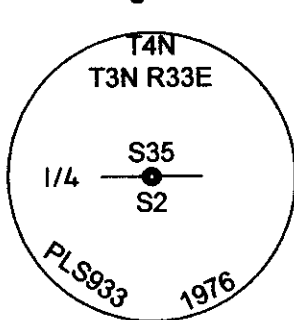

Sketch

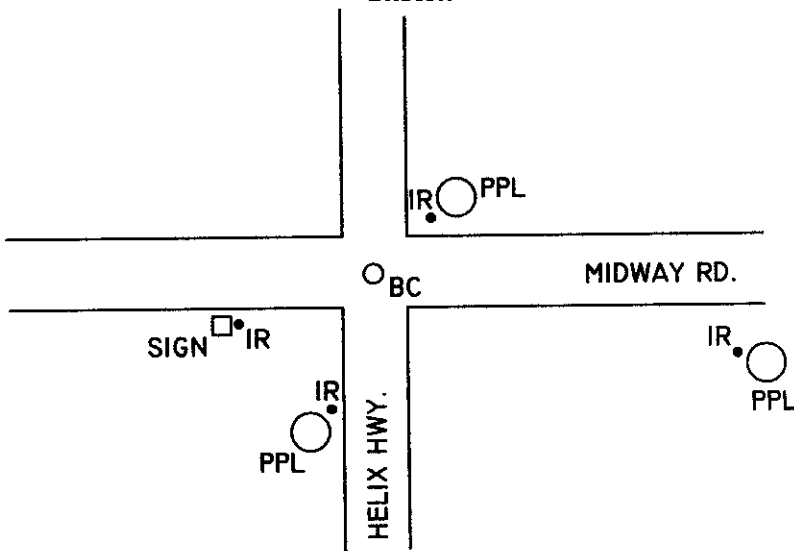

NAD 83/91
OREGON STATE PLANE NORTH
INTERNATIONAL FEET

N774365.13
E8673293.58

Monument(s) Set (Procedures and Description):

None.

References Set:

- A 5/8" x 30" iron rebar w/RPC #43406 lies S 78° E, 90.66', at a power pole.
- A 5/8" x 30" iron rebar w/RPC #43406 lies S 20° 20' W, 64.06', at a power pole.
- A 5/8" x 30" iron rebar w/RPC #43406 lies S 71° 30' W, 60.70', at a stop sign.

Location and Comments:

The corner is located in the intersection of Midway Rd. and the Helix Hwy.

Compass Declination

17° E

Surveyors Seal

REGISTERED
PROFESSIONAL
LAND SURVEYOR

Robert D. English
OREGON
JANUARY 11, 2005
ROBERT DOUGLAS ENGLISH
43406LS

RECEIVED BY:

Date: 7/10/2012
Rec'd By: S. Oles
No. 12-094-C

Firm / Agency

Survey One, LLC.
P.O. Box 382
Pendleton, OR 97801
(541) 276-2055

RENEWAL DATE: 12/31/13