

OREGON CORNER RESTORATION FORM

Section 4 Township 3N Range 33E

C-11

County Umatilla Date 11-8-85

CORNER DESIGNATION


- Condition Report Only
- Not Found
- Renewed
- Unrecorded
- Surveyed In
- Referenced Out

Previous Renewals/Surveys, etc. None


Monument(s) & Accessories Found: (Condition and Source)

None

Monument Detail

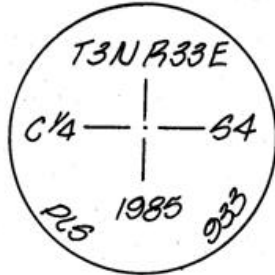

Sketch

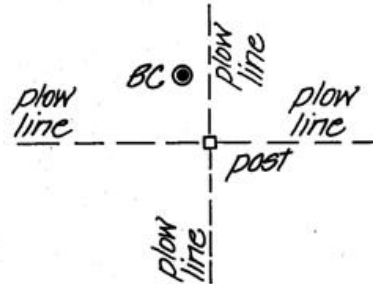

Monument Set (Procedures and Description)

2 1/2" Brass Cap on 1 1/2" galvanized pipe set 9.5 feet North and 4 feet West of a wood post at the intersection of two plow lines and set 12" below surface

New Accessories

Location & Comments

Surveyor's Seal

Compass Declination _____

Firm/Agency Krumbein

Engineering Ltd.

Address 361 S.E. Second
Pendleton, Oregon 97801

Party Chief R. Panches

Notes _____

Witness S. Carlson

RECEIVED BY

Umatilla County Surveyor

Date 6-26-85

Rec'd By KA

No. 86-77-R

