

OREGON CORNER RESTORATION FORM

Section: 4, 5 Township: 3N Range: 33E
County: Umatilla Date: 5/18/2011

Corner Designation: 3N33C09

Quarter corner common to Sections 4,5, T3NR33E.

	Condition Report Only
X	Not Found
X	Remonumented
	Unrecorded
X	Surveyed In
X	Referenced Out


Previous Renewals / Surveys, etc.

Originally surveyed by Chaplin in 1864. He set a post in a mound of earth.

Monuments and Accessories Found: (Condition and Source):


None.

Diagram

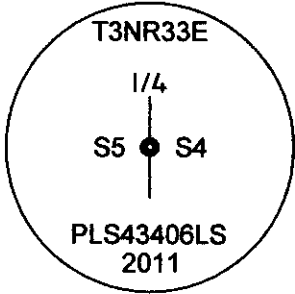

ORANGE
MAGNET

Sketch

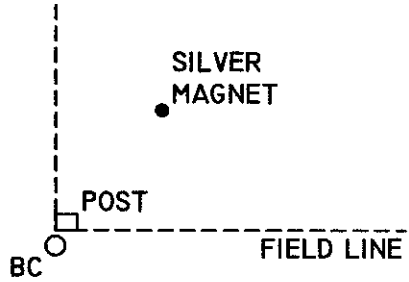

NAD 83/91
OREGON STATE PLANE NORTH
INTERNATIONAL FEET

N771396.39
E8660247.59

BLUE
MAGNET

PINK
MAGNET

Monument(s) Set (Procedures and Description):

A 1 1/8" x 30" galvanized iron pipe with 2 1/2" brass cap, stamped as shown above, flush with the ground surface. Monument is set near the base of an old juniper post that appears to have been held as the corner for a very long time. I find this to be the best evidence of the original corner location.

References Set:

- "Deep One" magnets by Berntsen.
- An orange magnet lies N 52° W, 22.72', 1.2' deep.
- A silver magnet lies N 48° 15' E, 19.54', 1.3' deep.
- A pink magnet lies S 37° 30' E, 23.64', 1.3' deep.
- A blue magnet lies S 38° W, 25.88', 1.3' deep.

Location and Comments:

The corner is located 1/2 mile South and 1/2 mile East of the intersection of Midway Rd. and Myrick Rd.

Compass Declination

17° E

Surveyors Seal

REGISTERED
PROFESSIONAL
LAND SURVEYOR

Robert D. English
OREGON
JANUARY 11, 2005
ROBERT DOUGLAS ENGLISH
434.06LS

RENEWAL DATE: 12/31/13

RECEIVED BY:

Firm / Agency

Date: 7/10/2012
Rec'd By: A. O'Neil
No. 12-094-C

Survey One, LLC.
P.O. Box 382
Pendleton, OR 97801
(541) 276-2055