

OREGON CORNER RESTORATION FORM

Section: 1, 12, 6, 7
County: Umatilla

Township: 3N
Date: 4/11/2011

Range: 32E, 33E

Corner Designation: 3N33E01

Section corner common to Sections 1, 12, T3NR32E; 6, 7, T3NR33E.

<input checked="" type="checkbox"/>	Condition Report Only
<input type="checkbox"/>	Not Found
<input type="checkbox"/>	Remonumented
<input type="checkbox"/>	Unrecorded
<input type="checkbox"/>	Surveyed In
<input checked="" type="checkbox"/>	Referenced Out

Previous Renewals / Surveys, etc.

Originally surveyed by Thompson in 1864. He set a post in a mound of earth.

The N. P. Ry. "Wallula to Pendleton" Right of Way Plat, Umatilla County Railroad Map #119 and Map #126, show the corner at 745.6' East of the track centerline. Map #126 and Map #131 show the corner at 1,619.0' South of the track centerline.

In 1971 Staebler found a charred stake in the road and set a 5/8" iron rebar monument with brass capped witness corners to the Northeast and Southwest as recorded in E25-H-179.



In 2002 Tomkins found a 5/8" x 12" rebar in McCormach Rd., a brass capped witness corner to the Southwest, both in good condition. He also found the Northeast brass capped witness corner leaning against a field berm and reset it. Recorded in E1-03-25G.

Monuments and Accessories Found: (Condition and Source):

A 5/8" iron rebar.

A 2 1/2" brass capped witness corner lies N 45°15' E, 30.35'. Has been moved from original location.

A 2 1/2" brass capped witness corner lies S 45° W, 35.36'.

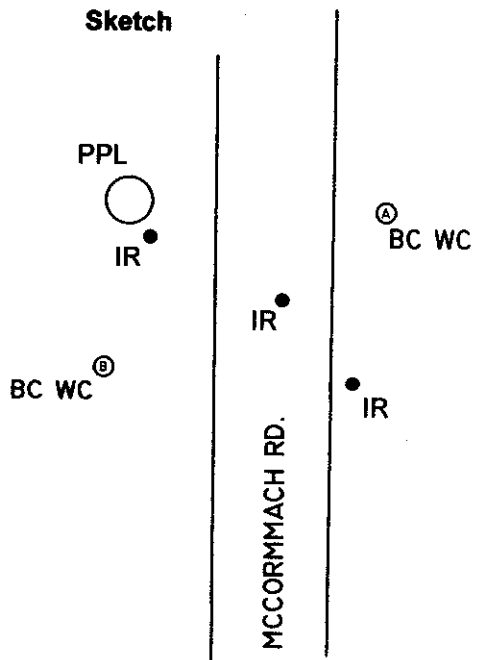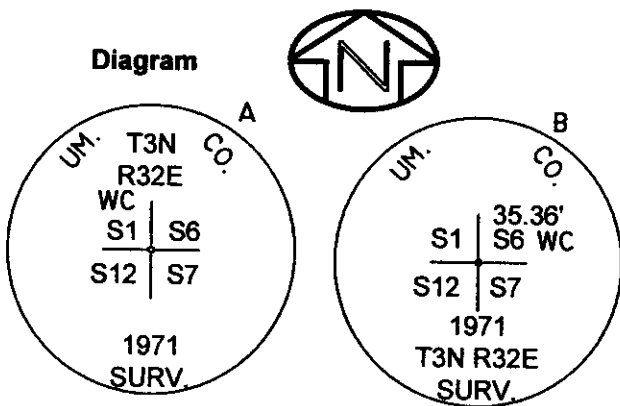

NAD 83/91
OREGON STATE PLANE NORTH
INTERNATIONAL FEET

N768606.59
E8649882.76

Monument(s) Set (Procedures and Description):

None.

References Set:

A 5/8" x 30" iron rebar w/RPC #43406 lies S 26° E, 43.31'.

A 5/8" x 30" iron rebar w/RPC #43406 lies N 60° W, 33.25', at a power pole.

Location and Comments:

The corner is located 1 mile South of the intersection of Midway Rd. and McCormach Rd.

Compass Declination

17° E

Surveyors Seal

REGISTERED
PROFESSIONAL
LAND SURVEYOR

Robert D. English
OREGON
JANUARY 11, 2005
ROBERT DOUGLAS ENGLISH
43406LS

RENEWAL DATE: 12/31/13

RECEIVED BY:

Date: 7/10/2012
Rec'd By: [Signature]
No. 12-094-C

Firm / Agency

Survey One, LLC.
P.O. Box 382
Pendleton, OR 97801
(541) 276-2055