

**OREGON CORNER RESTORATION FORM**

Section: 3, 4, 9, 10  
 County: Umatilla

Township: 3N  
 Date: 8/16/2011

Range: 33E

Corner Designation: 3N33E13

Section corner common to Sections 3, 4, 9, 10, T3NR33E.

<input checked="" type="checkbox"/>	Condition Report Only
<input type="checkbox"/>	Not Found
<input type="checkbox"/>	Remonumented
<input type="checkbox"/>	Unrecorded
<input type="checkbox"/>	Surveyed In
<input checked="" type="checkbox"/>	Referenced Out


**Previous Renewals / Surveys, etc.**

Originally surveyed by Chaplin in 1864. He set a post in a mound of earth.  
 In 1985 Krumbain set a 1 1/2" galvanized pipe with a 2 1/2" brass cap.  
 In 2005 Flowers found a brass cap in Survey 05-194-B.

**Monuments and Accessories Found: (Condition and Source):**


A 2 1/2" brass cap, stamped as shown below, 10" below the surface, 10' M/L North of old fence post at field line intersection.

Diagram

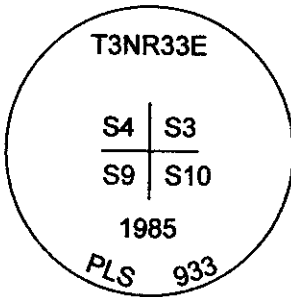

NAD 83/91  
 OREGON STATE PLANE NORTH  
 INTERNATIONAL FEET  
 N768848.35  
 E8665687.16

Sketch

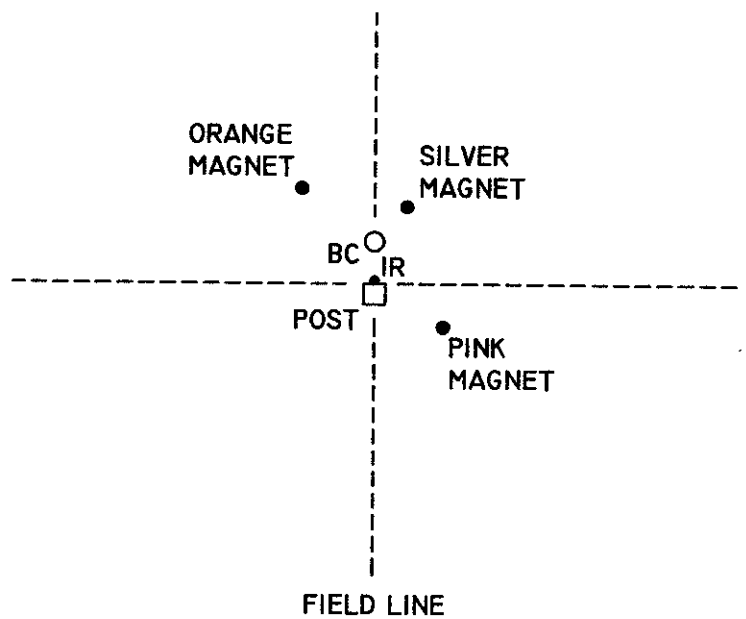

**Monument(s) Set (Procedures and Description):**  
 None.

**References Set:**

"Deep One" magnets by Berntsen.  
 An orange magnet lies N 52° 50' W, 20.03', 15" deep.  
 A silver magnet lies N 44° 10' E, 11.92', 16" deep.  
 A pink magnet lies S 38° 20' E, 33.49' 14" deep.  
 A 5/8" x 30" iron rebar w/RPC #43406 lies S 3° 30' E, 8.69', at an old fence post.

**Location and Comments:**

The corner is located 1 mile South of the intersection of Midway Rd. and Molstrom Rd.

**Compass Declination**  
 17° E

**Surveyors Seal**

REGISTERED  
 PROFESSIONAL  
 LAND SURVEYOR

*Robert D. English*  
 OREGON  
 JANUARY 11, 2005  
 ROBERT DOUGLAS ENGLISH  
 43406LS

RENEWAL DATE: 12/31/13

**RECEIVED BY:**

Date: 7/10/2012  
 Rec'd By: A. Des  
 No. 12-094-C

**Firm / Agency**

Survey One, LLC.  
 P.O. Box 382  
 Pendleton, OR 97801  
 (541) 276-2055