

OREGON CORNER RESTORATION FORM

Section 4 Township 3N Range 33E

E-13

County Umatilla Date 11-8-85

CORNER DESIGNATION

- Condition Report Only
- Not Found
- Renewed
- Unrecorded
- Surveyed In
- Referenced Out

Previous Renewals/Surveys, etc. None


Monument(s) & Accessories Found: (Condition and Source)

Found a Wood post which is South of property corner by 10 feet as told to us by the neighboring farmer to the East

Monument Detail



Sketch

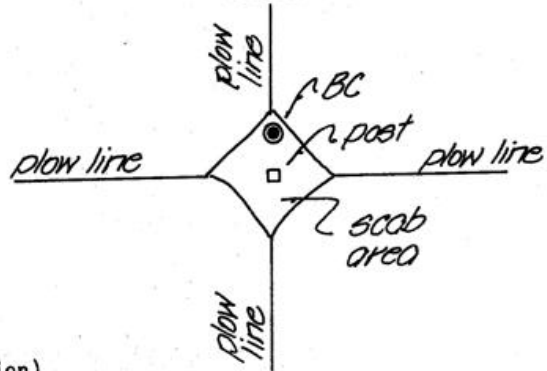

Monument Set (Procedures and Description)

2 1/2" Brass Cap on 1 1/2" Galvanized pipe set 10 feet North of a wood post at the intersection of plow lines and burried 12" below surface

New Accessories

Location & Comments

Surveyor's Seal

RECEIVED BY \_\_\_\_\_  
 Umatilla County Surveyor \_\_\_\_\_  
 Date 6-25-86  
 Rec'd By SA  
 No. 86-71-R

Compass Declination \_\_\_\_\_  
 Firm/Agency Krumbein  
 Engineering Ltd \_\_\_\_\_  
 Address 361 S.E. Second  
Pendleton, Oregon 97801  
 Party Chief R. Punches  
 Notes \_\_\_\_\_  
 Witness S. Carlson

