

OREGON CORNER RESTORATION FORM

Section: 2, 3, 10, 11
County: Umatilla

Township: 3N
Date: 2/14/2011

Range: 33E

Corner Designation: 3N33E17

Section corner common to Sections 2, 3, 10, 11, T3NR33E.

- Condition Report Only
- Not Found
- Remonumented
- Unrecorded
- Surveyed In
- Referenced Out


Previous Renewals / Surveys, etc.

Originally surveyed by Chaplin in 1864. He set a post in a mound of earth.
In 1985 Krumbain set a 2 1/2" brass cap at a 3-way intersection.


Monuments and Accessories Found: (Condition and Source):

A 2 1/2" brass cap, stamped as shown below.

Diagram

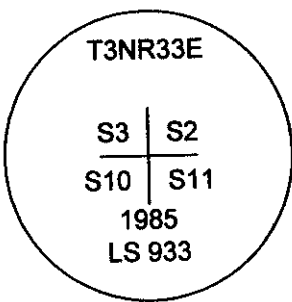

Sketch

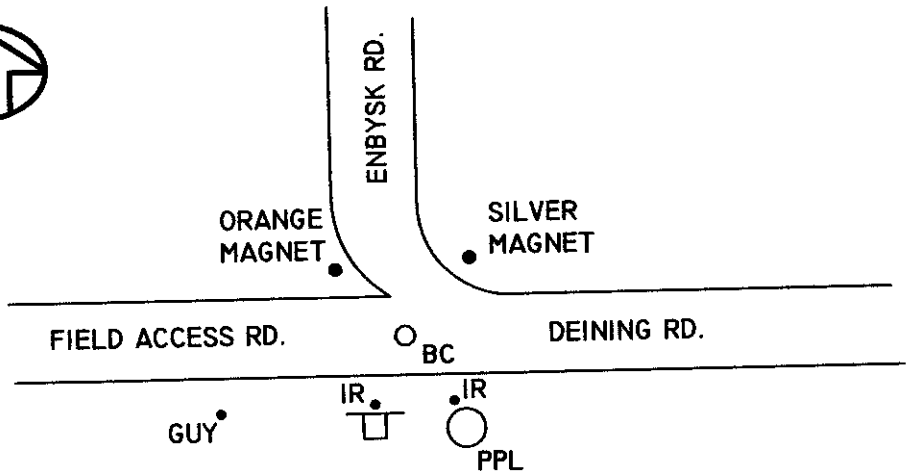

NAD 83/91
OREGON STATE PLANE NORTH
INTERNATIONAL FEET

N768951.98
E8670963.27

Monument(s) Set (Procedures and Description):

None.

References Set:

- "Deep One" magnets by Berntsen.
- An orange magnet lies N 43° 50' W, 42.82', 13" deep.
- A silver magnet lies N 30° 40' E, 41.15', 14" deep.
- A 5/8" iron rebar w/RPC #43406 lies S 30° 30' E, 20.24', at a power pole.
- A 5/8" iron rebar w/RPC #43406 lies S 18° 10' W, 15.63', at a road sign.

Location and Comments:

The corner is at the intersection of Deining Rd. and Enbysk Rd.

Compass Declination

17° E

Surveyors Seal

REGISTERED
PROFESSIONAL
LAND SURVEYOR

Robert D. English

OREGON
JANUARY 11, 2005
ROBERT DOUGLAS ENGLISH
43406LS

RENEWAL DATE: 12/31/13

RECEIVED BY:

Date: 7/10/2012
Rec'd By: A. P. [Signature]
No. 12-094-C

Firm / Agency

Survey One, LLC.
P.O. Box 382
Pendleton, OR 97801
(541) 276-2055