

OREGON CORNER RESTORATION FORM

Section 1,12 Township 3N
County Umatilla Date: 03/25/11

Range 33E

Corner Designation: 3N33E23

1/4 Corner common to section 1 and 12 T3NR33E.

- Condition Report Only
- Not Found
- Remonumented
- Unrecorded
- Surveyed In
- Referenced Out

Previous Renewals / Surveys, etc.



Originally Surveyed by Chaplin in 1864. He set a post in a mound of earth.

Monuments and Accessories Found: (Condition and Source)

None.

Sketch

Diagram

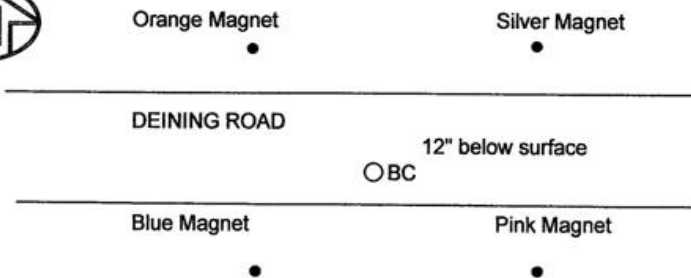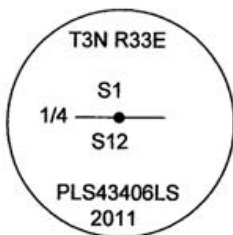

NAD 83/91
OREGON STATE PLANE NORTH
INTERNATIONAL FEET

N769183.55
E8678845.84

Monument (s) Set (Procedures and Description)

A 1 1/4" Galvanized Iron pipe w/ 2 1/2" Brass cap stamped as shown above. Set by single proportionate methods between monuments West and East.

References Set: "Deep One" Magnets by Berntsen.

An Orange Magnet 18" deep, lies N 35°50' W, 22.88'.

A Silver Magnet 19" deep, lies N 24°50' E, 24.26'.

A Pink Magnet 19" deep, lies S 50°10' E, 22.05'.

A Blue Magnet 18" deep, lies S 44°20' W, 19.40'

Location and Comments

The corner is 1 mile East of the intersection of Straughan Road and Deining Road.

Compass Declination

17° E

Surveyors Seal

REGISTERED
PROFESSIONAL
LAND SURVEYOR

Robert D. English
OREGON
JANUARY II, 2005
ROBERT DOUGLAS ENGLISH
43406LS

RECEIVED BY:

Date: _____
Rec'd By: _____
No. _____

Firm / Agency

Survey One, LLC.
P.O. Box 382
Pendleton, OR 97801
(541) 276-2055

RENEWAL DATE: 12/31/11