

OREGON CORNER RESTORATION FORM

Section 5 Township 3N
County Umatilla Date: 03/15/11

Range 33E

Corner Designation: 3N33E9

Corner common to sections 4,5,8 and 9, T3NR33E.

- Condition Report Only
- Not Found
- Remonumented
- Unrecorded
- Surveyed In
- Referenced Out


Previous Renewals / Surveys, etc.

Originally Surveyed by Chaplin in 1864. He set a post in a mound of earth.


Monuments and Accessories Found: (Condition and Source)

None.

Diagram

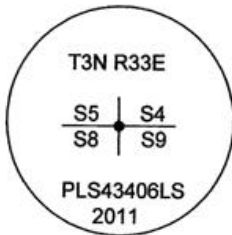

Sketch

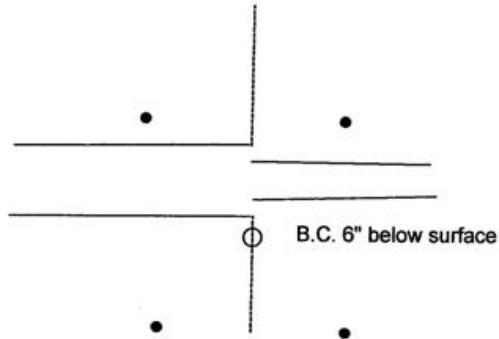

NAD 83/91
OREGON STATE PLANE NORTH
INTERNATIONAL FEET

N768764.50
E8660369.33

Monument (s) Set (Procedures and Description)

A 30" x 1 1/8" galvanized iron pipe with a 2 1/2" brass cap, 6" below surface, stamped as shown above.

References Set:

- A Silver magnet, 19" deep, lies N 36°20' E, 37.57'.
- A Pink magnet, 18" deep, lies S 44°20' E, 27.64'.
- A Blue magnet, 18" deep, lies S 40° W, 23.62'.
- An Orange magnet, 18" deep, lies N 33°20' W, 36.47'.

Location and Comments

The corner is 0.5 miles East of the intersection of Anderson Road and Myrick Road.

Compass Declination

17° E

Surveyors Seal

REGISTERED
PROFESSIONAL
LAND SURVEYOR

Robert D. English
OREGON
JANUARY 11, 2005
ROBERT DOUGLAS ENGLISH
43406LS

RENEWAL DATE: 12/31/11

RECEIVED BY:

Date: _____
Rec'd By: _____
No. _____

Firm / Agency

Survey One, LLC.
P.O. Box 382
Pendleton, OR 97801
(541) 276-2055