

OREGON CORNER RESTORATION FORM

Section 7 Township 3N
County Umatilla Date: 03/14/11

Range 33E

Corner Designation: 3N33G1

1/4 corner common to sections 7, T3NR33E, 12,
T3NR32E.

_____	Condition Report Only
X	Not Found
X	Remonumented
_____	Unrecorded
X	Surveyed In
X	Referenced Out

Previous Renewals / Surveys, etc.

Originally Surveyed by Thompson in 1864. He set a post in a mound of earth.
Moody set a post in a mound of earth in 1871.


Monuments and Accessories Found: (Condition and Source)

None.

Diagram



Sketch

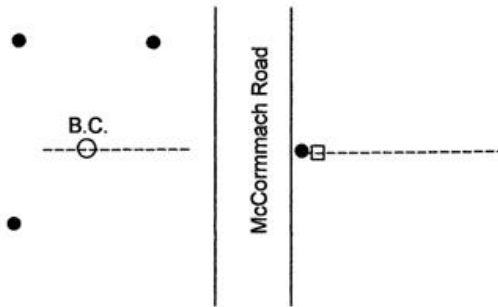

NAD 83/91
OREGON STATE PLANE NORTH
INTERNATIONAL FEET

N765956.83
E8649936.36

Monument (s) Set (Procedures and Description)

Set a 2 1/2" Brass cap on a 1 1/8" x 30" galvanized iron pipe 22 inches below the surface, by single proportionate method, holding the old fence post at field intersection next to road (for Northing), as best evidence of the original corner position. I have found corner posts common in this area.

References Set: "Deep One" magnets by Berntsen.

- A Silver magnet, 20" deep, lies N 32°30' E, 23.63'.
- A 3/8" Iron rebar w/rpc #43406 lies N 89°50' E, 85.57'.
- A Blue magnet, 23" deep, lies S 30° W, 35.31'.
- An Orange magnet, 20" deep, lies N 58°30' W, 28.42'.

Location and Comments

From the intersection Shafer Road
and McCormmach Road North 0.5 miles.

Compass Declination

17° E

Surveyors Seal

REGISTERED
PROFESSIONAL
LAND SURVEYOR

Robert D. English
OREGON
JANUARY II, 2005
ROBERT DOUGLAS ENGLISH
43406LS

RECEIVED BY:

Date: _____
Rec'd By: _____
No. _____

Firm / Agency

Survey One, LLC.
P.O. Box 382
Pendleton, OR 97801
(541) 276-2055

RENEWAL DATE: 12/31/11