

OREGON CORNER RESTORATION FORM

Section: 10, 15 Township: 3N Range: 33E
County: Umatilla Date: 6/27/2012

Corner Designation: 3N33J15

Quarter corner common to Sections 10, 15, T3NR33E.

_____	Condition Report Only
_____	Not Found
_____X_____	Remonumented
_____	Unrecorded
_____	Surveyed In
_____X_____	Referenced Out


Previous Renewals / Surveys, etc.

Originally surveyed by Chaplin in 1864. He set a post in a mound of earth with charred stake and pits.
In 1954 J. Grey found part of a stake w/ ashes and set a 1/2" round iron rod in Survey Q-526-A.
In 1981 Krumbein found a 5/8" iron pin in Survey S-153-B.
In 1986 W. Wells found a railroad spike in Survey 86-003-B.
In 1988 W. Wells found a railroad spike in Survey 88-017-B.


Monuments and Accessories Found: (Condition and Source):

A railroad spike at the corner location, 3" deep.
A 60D spike at the corner location, 12" deep.
A 1/2" x 24" smooth iron rod at the corner location, 16" deep.
A 1" hex steel shank lies North, 20.00'.
A 1" hex steel shank lies South, 20.00'

Diagram

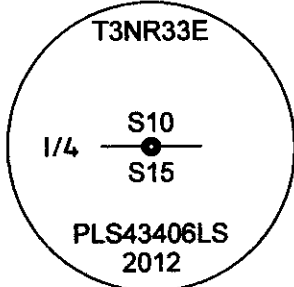

Sketch

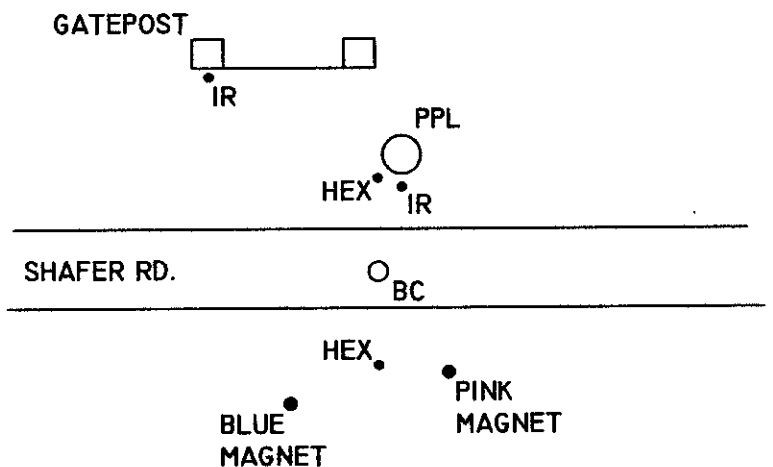

NAD 83/91
OREGON STATE PLANE NORTH
INTERNATIONAL FEET

N763616.45
E8668440.10

Monument(s) Set (Procedures and Description):

A 1 1/8" galvanized iron pipe with 2 1/2" brass cap, stamped as shown above, 1.6' below the surface at the existing corner location, with the railroad spike, 60D spike and 1/2" x 24" smooth iron rod buried alongside.

References Set:

"Deep One" magnets by Berntsen.
A 5/8" x 30" iron rebar lies N 36° 30' W, 51.65', at a railroad tie gatepost.
A 5/8" x 30" iron rebar lies N 26° 30' E, 19.77', at a power pole.
A pink magnet lies S 40° 35' E, 27.33', 1.7' deep.
A blue magnet lies S 30° 15' W, 30.77', 1.7' deep.

Location and Comments:

The corner is located in Shafer Rd. 1 mile West of the intersection of Shafer Rd. and the Helix Hwy.

Compass Declination
17° E

Surveyors Seal

REGISTERED
PROFESSIONAL
LAND SURVEYOR

Robert D. English
OREGON
JANUARY 11, 2005
ROBERT DOUGLAS ENGLISH
43406LS

RECEIVED BY:

Firm / Agency

Survey One, LLC.
P.O. Box 382
Pendleton, OR 97801
(541) 276-2055

RENEWAL DATE: 12/31/13

Date: 7/10/2012
Rec'd By: [Signature]
No. 12-094-C