

**OREGON CORNER RESTORATION FORM**

Section: 11, 14  
County: Umatilla

Township: 3N  
Date: 3/23/2011

Range: 33E

Corner Designation: 3N33J19 (Amended 4/2/2012)

Quarter corner common to Sections 11, 14, T3NR33E.

- Condition Report Only
- Not Found
- Remonumented
- Unrecorded
- Surveyed In
- Referenced Out


**Previous Renewals / Surveys, etc.**

Originally surveyed by Chaplin in 1864. He set a post in a mound of earth. In 1988 W. Wells set a 1 1/2" x 16" galvanized iron pipe with a 2 1/2" brass cap, stamped as shown below, in a monument box in the pavement in Survey 88-17-B. In 2008 Stockhoff recovered a 2 1/2" brass cap in Survey 09-042-B.


**Monuments and Accessories Found: (Condition and Source):**

None.

Diagram

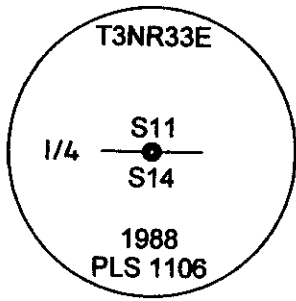

Sketch

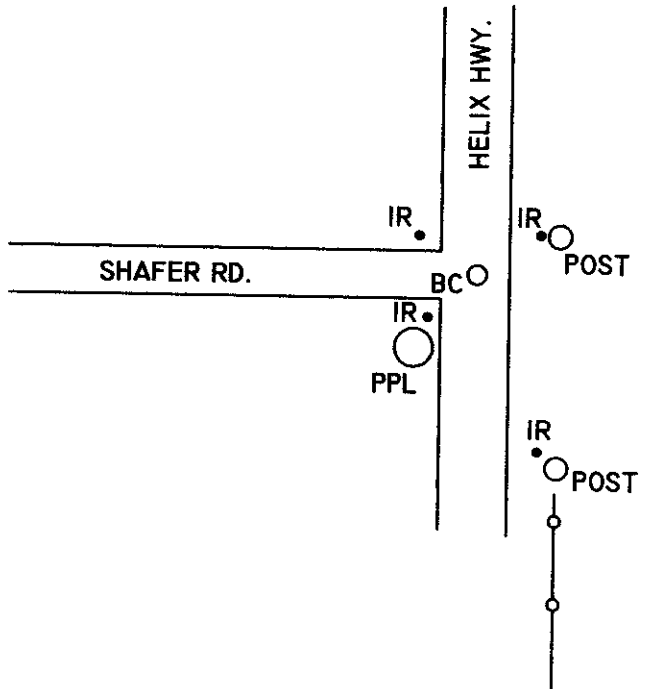

NAD 83/91  
OREGON STATE PLANE NORTH  
INTERNATIONAL FEET

N763731.85  
E8673724.34

**Monument(s) Set (Procedures and Description):**

None.

**References Set:**

- A 5/8" x 30" iron rebar w/RPC #43406 lies N 54° W, 44.34'.
- A 5/8" x 30" iron rebar w/RPC #43406 lies N 83° 20' E, 23.16'.
- A 5/8" x 30" iron rebar w/RPC #43406 lies S 17° 30' E, 91.01'.
- A 5/8" x 30" iron rebar w/RPC #43406 lies S 43° 10' W, 35.42'.

**Location and Comments:**

The corner is located at the intersection of Shafer Rd. and the Helix Hwy.

**Compass Declination**

17° E

**Surveyors Seal**

REGISTERED  
PROFESSIONAL  
LAND SURVEYOR

*Robert D. English*  
OREGON  
JANUARY 11, 2005  
ROBERT DOUGLAS ENGLISH  
43406LS

**RECEIVED BY:**

**Firm / Agency**

Date: 7/10/2012  
Rec'd By: S. Oles  
No. 12-094-C

Survey One, LLC.  
P.O. Box 382  
Pendleton, OR 97801  
(541) 276-2055

RENEWAL DATE: 12/31/13