

**OREGON CORNER RESTORATION FORM**

Section: 13, 14 Township: 3N Range: 33E  
County: Umatilla Date: 2/9/2012

Corner Designation: 3N33L21

Quarter corner common to Sections 13, 14, T3NR33E.

	Condition Report Only
X	Not Found
X	Remonumented
	Unrecorded
X	Surveyed In
X	Referenced Out


**Previous Renewals / Surveys, etc.**

Originally surveyed by Chaplin in 1864. He set a post in a mound of earth, with charred stake and pits. In 1899 J. Kimbrell set a 22" x 8" x 6" stone in Private Survey No. 113, as recorded in Book 1, pg. 420.

**Monuments and Accessories Found: (Condition and Source):**

None.

**Diagram**

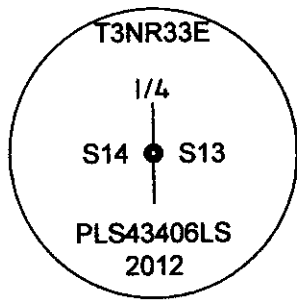

**Sketch**

ORANGE  
MAGNET ●

SILVER  
MAGNET ●

○ BC

NAD 83/91  
OREGON STATE PLANE NORTH  
INTERNATIONAL FEET

N761172.05  
E8676434.51

BLUE  
MAGNET ●

PINK  
MAGNET ●

**Monument(s) Set (Procedures and Description):**

A 1 1/8" x 30" galvanized iron pipe with 2 1/2" brass cap, stamped as shown above, 1.5' below the surface. The corner location was reestablished by single proportionate method between neighboring corners to the North and South, in an active wheat field.

**References Set:**

- "Deep One" magnets by Berntsen.
- An orange magnet lies N 41° 25' W, 23.95', 1.8' deep.
- A silver magnet lies N 43° 45' E, 22.74', 1.8' deep.
- A pink magnet lies S 52° 30' E, 28.89', 1.7' deep.
- A blue magnet lies S 35° W, 27.48', 1.7' deep.

**Location and Comments:**

The corner is located 1/2 mile South and 1/2 mile East of the intersection of Shafer Rd. and the Helix Hwy., in an active wheat field.

**Compass Declination**

17° E

**Surveyors Seal**

REGISTERED  
PROFESSIONAL  
LAND SURVEYOR

*Robert D. English*  
OREGON  
JANUARY 11, 2005  
ROBERT DOUGLAS ENGLISH  
43406LS

**RECEIVED BY:**

Date: 2/9/2012  
Rec'd By: S. Oles  
No. 12-094-C

**Firm / Agency**

Survey One, LLC.  
P.O. Box 382  
Pendleton, OR 97801  
(541) 276-2055

RENEWAL DATE: 12/31/13