

**OREGON CORNER RESTORATION FORM**

Section: 13, 18 Township: 3N Range: 33E, 34E  
County: Umatilla Date: 3/7/2012

Corner Designation: 3N33L25

Quarter corner common to Sections 13, T3NR33E; 18, T3NR34E.

_____	Condition Report Only
<u>  X  </u>	Not Found
<u>  X  </u>	Remonumented
_____	Unrecorded
<u>  X  </u>	Surveyed In
<u>  X  </u>	Referenced Out


**Previous Renewals / Surveys, etc.**

Originally surveyed by Thompson in 1864. He set a post in a mound of earth, with charred stake, pits, and trench.

**Monuments and Accessories Found: (Condition and Source):**

None.


**Diagram**

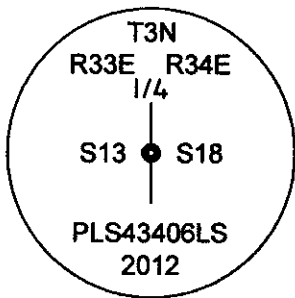

ORANGE MAGNET

BLUE MAGNET

**Sketch**

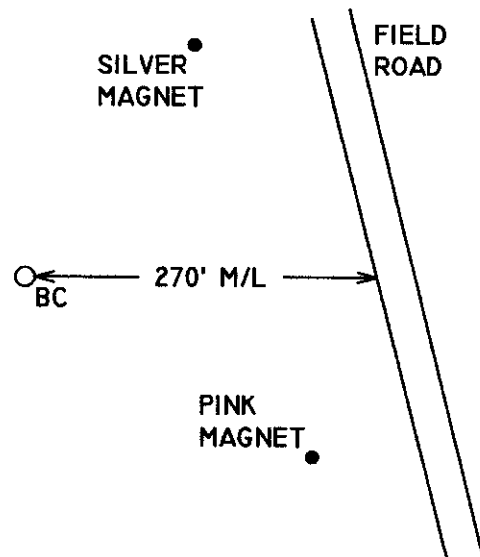

NAD 83/91  
OREGON STATE PLANE NORTH  
INTERNATIONAL FEET

N761341.66  
E8681657.78

**Monument(s) Set (Procedures and Description):**

A 1 1/8" x 30" galvanized iron pipe with 2 1/2" brass cap, stamped as shown above, 1.25' below the surface. The corner location was reestablished by single proportionate method between found corners to the North and South, in an active wheat field North of a ranch house.

**References Set:**

- "Deep One" magnets by Berntsen.
- An orange magnet lies N 54° W, 24.89', 1.6' deep.
- A silver magnet lies N 37° E, 29.94', 1.8' deep.
- A pink magnet lies S 56° 30' E, 35.27', 1.7' deep.
- A blue magnet lies S 29° 30' W, 34.88', 1.7' deep.

**Location and Comments:**

The corner is located 1 mile, M/L, West of the intersection of Hwy. 11 and Rockroth Rd.

**Compass Declination**

17° E

**Surveyors Seal**

REGISTERED  
PROFESSIONAL  
LAND SURVEYOR

*Robert D. English*  
OREGON  
JANUARY 11, 2005  
ROBERT DOUGLAS ENGLISH  
43406LS

**RECEIVED BY:**

**Firm / Agency**

Date: 7/10/2012  
Rec'd By: S. Ples  
No. 12-094-C

Survey One, LLC.  
P.O. Box 382  
Pendleton, OR 97801  
(541) 276-2055

RENEWAL DATE: 12/31/13