

OREGON CORNER RESTORATION FORM

Section: 16, 21 Township: 3N Range: 33E
County: Umatilla Date: 3/22/2011

Corner Designation: 3N33N11 (Amended 3/16/2012)

Quarter corner common to Sections 16, 21, T3NR33E.

Condition Report Only
X Not Found
X Remonumented
Unrecorded
X Surveyed In
X Referenced Out


Previous Renewals / Surveys, etc.

Originally surveyed by Chaplin in 1864. He set a 24" x 12" x 5" stone.


Monuments and Accessories Found: (Condition and Source):

None.

Diagram

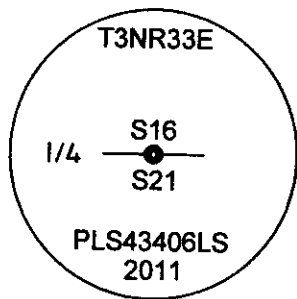

Sketch

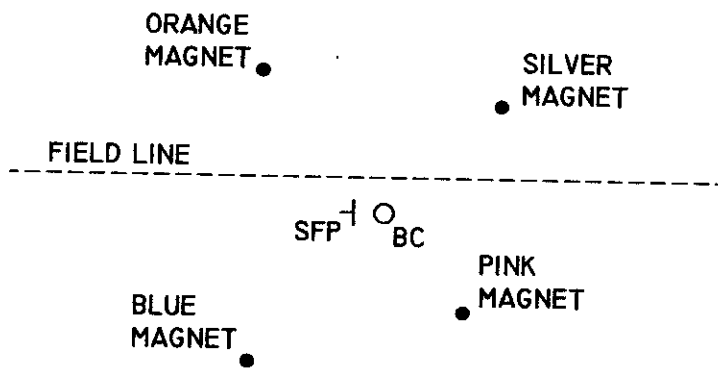

NAD 83/91
OREGON STATE PLANE NORTH
INTERNATIONAL FEET

N758263.36
E8663277.54

Monument(s) Set (Procedures and Description):

A 1 1/2" x 30" galvanized iron pipe with a 2 1/2" brass cap, stamped as shown above, 1.3' below the surface, at the corner reestablished by single proportionate method between found corners.

References Set:

- "Deep One" magnets by Berntsen.
- An orange magnet lies N 41° 20' W, 24.69', 1.6' deep.
- A silver magnet lies N 47° 20' E, 21.27', 1.6' deep.
- A pink magnet lies S 39° 10' E, 20.14', 1.7' deep.
- A blue magnet lies S 41° 40' W, 28.90', 1.7' deep.

Location and Comments:

The corner is located 1 mile East of the intersection of Fulton Rd. and Myrick Rd.

Compass Declination

17° E

Surveyors Seal

REGISTERED
PROFESSIONAL
LAND SURVEYOR

Robert D. English
OREGON
JANUARY 11, 2005
ROBERT DOUGLAS ENGLISH
43406LS

RENEWAL DATE: 12/31/13

RECEIVED BY:

Firm / Agency

Survey One, LLC.
P.O. Box 382
Pendleton, OR 97801
(541) 276-2055

Date: 7/10/2012
Rec'd By: [Signature]
No. 12-094-c