

OREGON CORNER RESTORATION FORM

Section 15,16,21,22 Township 3N
County Umatilla Date: 03/22/11

Range 33E

Corner Designation: 3N33N13

Corner common to Sections 15,16,21 and 22 T3NR33E.

- Condition Report Only
- Not Found
- Remonumented
- Unrecorded
- Surveyed In
- Referenced Out


Previous Renewals / Surveys, etc.

Originally Surveyed by Chaplin in 1864. He set a post in a mound of earth.
Surveyed by Moody in 1871. He set a post in a mound of earth.


Monuments and Accessories Found: (Condition and Source)

None.

Diagram

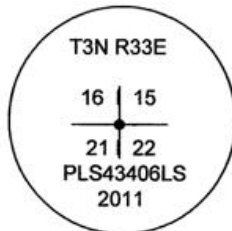

Sketch

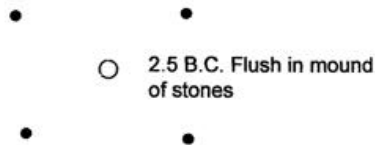

NAD 83/91
OREGON STATE PLANE NORTH
INTERNATIONAL FEET

N758319.76
E8665922.62

Monument (s) Set (Procedures and Description)

A 1 1/8" x 30" galvanized iron pipe, with a 2 1/2" brass cap, stamped as shown above in mound of large stones at a field intersection. I accept this as best evidence and has obviously been held as the corner for a long time.

References Set: "Deep One" magnets by Berntsen.

- A Silver magnet, 19" deep, lies N 43°20' E, 15.05'.
- A Pink magnet, 19" deep, lies S 28°50' E, 27.75'.
- A Blue magnet, 18" deep, lies S 35°30' W, 30.35'.
- An Orange magnet, 18" deep, lies N 50°20' W, 25.97'.

Location and Comments

The corner is 1.5 miles East of the intersection of Fulton Road and Myrick Road.

Compass Declination

17° E

Surveyors Seal

REGISTERED
PROFESSIONAL
LAND SURVEYOR

Robert D. English

OREGON
JANUARY II, 2005
ROBERT DOUGLAS ENGLISH
43406LS

RENEWAL DATE: 12/31/11

RECEIVED BY:

Date: _____
Rec'd By: _____
No. _____

Firm / Agency

Survey One, LLC.
P.O. Box 382
Pendleton, OR 97801
(541) 276-2055