

OREGON CORNER RESTORATION FORM

Section: 17, 18, 19, 20 Township: 3N Range: 33E
County: Umatilla Date: 4/20/2011

Corner Designation: 3N33N05

Section corner common to Sections 17, 18, 19, 20, T3NR33E.

	Condition Report Only
X	Not Found
X	Remonumented
	Unrecorded
X	Surveyed In
X	Referenced Out


Previous Renewals / Surveys, etc.

Originally surveyed by Chaplin in 1864. He set a post in a mound of earth.


Monuments and Accessories Found: (Condition and Source):

None.

Diagram

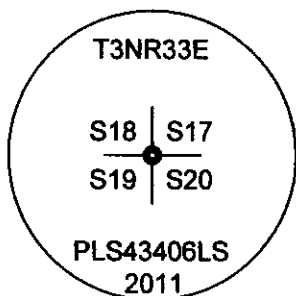

Sketch

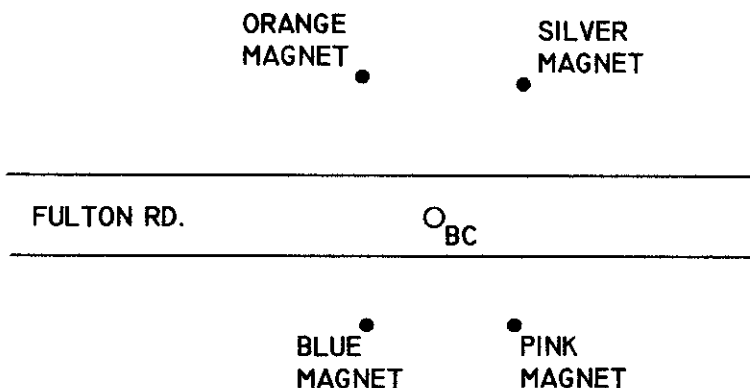

NAD 83/91
OREGON STATE PLANE NORTH
INTERNATIONAL FEET

N758135.42
E8655281.70

Monument(s) Set (Procedures and Description):

A 1 1/8" x 30" galvanized iron pipe with 2 1/2" brass cap, stamped as shown above, 11" below the surface. The corner location was reestablished by holding the centerline of Fulton Rd. for Northing, per Umatilla County Road Notes, and using single proportionate method between found evidence to the East and West as best available evidence of the original corner location.

References Set:

"Deep One" magnets by Berntsen.
An orange magnet lies N 34° 10' W, 24.78', 1.5' deep.
A silver magnet lies N 46° E, 27.68', 1.3' deep.
A pink magnet lies S 41° E, 24.07', 1.4' deep.
A blue magnet lies S 41° W, 24.40', 1.5' deep.

Location and Comments:

The corner is located 1/2 mile West of the intersection of Fulton Rd. and Myrick Rd.

Compass Declination

17° E

Surveyors Seal

REGISTERED
PROFESSIONAL
LAND SURVEYOR

Robert Douglas English
OREGON
JANUARY 11, 2005
ROBERT DOUGLAS ENGLISH
43406LS

RECEIVED BY:

Firm / Agency

Date: 7/10/2012
Rec'd By: A. [Signature]
No. 12-094-C

Survey One, LLC.
P.O. Box 382
Pendleton, OR 97801
(541) 276-2055

RENEWAL DATE: 12/31/13