

OREGON CORNER RESTORATION FORM

Section 20,21 Township 3N
County Umatilla Date: 03/17/11

Range 33E

Corner Designation: 3N33P9

Corner common to Sections 20,21, T3NR33E.

_____	Condition Report Only
<u> X </u>	Not Found
<u> X </u>	Remonumented
_____	Unrecorded
<u> X </u>	Surveyed In
<u> X </u>	Referenced Out


Previous Renewals / Surveys, etc.

Originally Surveyed by Chaplin. He set a post in a mound of earth in 1864.


Monuments and Accessories Found: (Condition and Source)

None.

Diagram

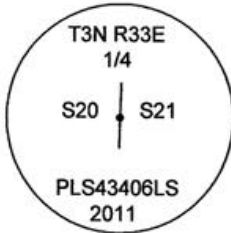

Sketch

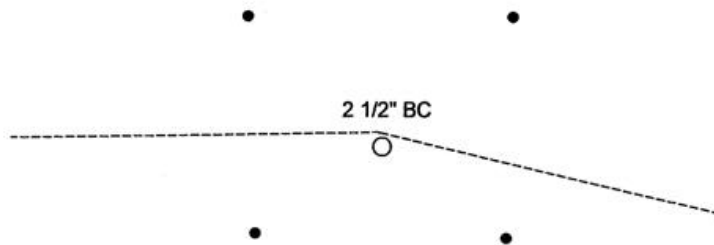

NAD 83/91
OREGON STATE PLANE NORTH
INTERNATIONAL FEET

N755575.86
E8660683.57

Monument (s) Set (Procedures and Description)

A 2 1/2" Brass cap on a 1" id x 30" galvanized Iron pipe, at the surface near a railroad tie post . Cap marked as shown above. Railroad post appears to match all field lines and has been held as the corner between properties. I hold this position as best evidence of the original position.

References Set: "Deep One" magnets by Berntsen.

- An Orange magnet, 20" deep, lies N 42° W, 11.45'.
- A Silver magnet, 21" deep, lies N 55°30' E, 13.31'.
- A Pink magnet, 24" deep, lies S 44° E, 16.19'.
- A Blue magnet, 20" deep, lies S 37° W, 13.87'.

Location and Comments

The corner is 0.5 miles East of Myrick Road and 0.5 miles North of Ramseys' House.

Compass Declination

17° E

Surveyors Seal

REGISTERED
PROFESSIONAL
LAND SURVEYOR

Robert D. English
OREGON
JANUARY 11, 2005
ROBERT DOUGLAS ENGLISH
43406LS

RENEWAL DATE: 12/31/11

RECEIVED BY:

Date: _____
Rec'd By: _____
No. _____

Firm / Agency

Survey One, LLC.
P.O. Box 382
Pendleton, OR 97801
(541) 276-2055